

MISSISSIPPI DEPARTMENT OF NATURAL RESOURCES

Bureau of Land and Water Resources

Southport Mall

P.O. Box 10631

Jackson, Mississippi 39209

WATER WELL DRILLERS LOG

CODED

B61
LEFLORE CO
3-14-84

3/14 1984 Dyer Well Leflore
date well completed firm name county well located

LANDOWNER: Eggen Planting Co
Co Gene Fedric
Glendora, Miss. 38928
(mailing address)

description of formations encountered	from	to
	<u>Clay</u>	<u>0</u>
<u>Fine Sand</u>	<u>40</u>	<u>58</u>
<u>Sand & Gravel</u>	<u>58</u>	<u>113</u>

WELL LOCATION:
sec. 47 T 22 N R 1 E
S 5 W 7
2 1/2 miles NW of Miner City
(distance) (direction) (nearest town)

WELL PURPOSE: Imp.
(home, irrigation, municipal, industrial)

WELL COMPLETION DATA:

(1) diameter (inches) 16"

(2) total depth (feet) 113'

(3) static water level (feet) 23' below above top of ground.

(4) casing STEEL, 73'
(material) (depth)
16" if telescope see back.
(size)

(5) screen 40 ft, 73'
(length) (depth to top)
16", MILD STEEL
(size) (material)

(6) pump 60 1000
(HP) (yield gpm)
DIESEL
(type power)

(7) electric log No
(yes or no)
(organization running log)

(8) how well bottom plugged STEEL PLATE

DRILLERS REMARKS:


CODED

DEPT. OF NATURAL RESOURCES
BUREAU OF LAND & WATER RESOURCES

MAY - 4 1984
RECEIVED

If well telescopes please sketch and show depths.

GROUND LEVEL

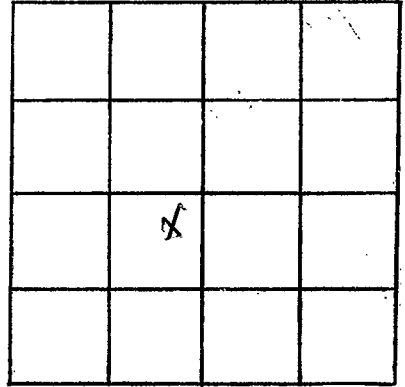

SECTION 2

Please indicate well location X.

ADDITIONAL INFORMATION

If more than one screen, show locations of each on sketch.