

MISSISSIPPI DEPARTMENT OF NATURAL RESOURCES

Bureau of Land and Water Resources

Southport Mall

P.O. Box 10631

Jackson, Mississippi 39209

CODED

WATER WELL DRILLERS LOG

B62
Leflore
8/2/84


6/2/84 date well completed 19 *Dyer well* firm name *Leflore* county well located

LANDOWNER:	description of formations encountered	from	to
(mailing address)			
<i>N. H. Somerville</i>	<i>Clay</i>	<i>20</i>	<i>28</i>
	<i>Fine Sand</i>	<i>28</i>	<i>38</i>
	<i>Sand</i>	<i>38</i>	<i>56</i>
	<i>Sand & Gravel</i>	<i>56</i>	<i>103</i>
WELL LOCATION:			
sec. <i>10</i> T <i>22</i> S R <i>1</i> E			
<i>3</i> miles <i>N</i> of <i>Miner City</i>			
(distance) (direction) (nearest town)			
WELL PURPOSE:			
(home, irrigation, municipal, industrial)			
WELL COMPLETION DATA:			
(1) diameter (inches) <i>16</i>			
(2) total depth (feet) <i>103</i>			
(3) static water level (feet) <i>16</i> below above top of ground.			
(4) casing <i>STEEL</i> <i>103</i> (material) (depth)			
<i>16</i> (size) if telescope see back.			
(5) screen <i>soft</i> <i>103</i> (length) (depth to top)			
<i>16</i> (size) <i>STEEL</i> (material)			
(6) pump <i>600</i> <i>1400</i> (HP) (yield gpm)			
<i>DIPS</i> (type power)			
(7) electric log <i>No</i> (yes or no)			
<i>No</i> (organization running log)			
(8) how well bottom plugged <i>STEEL PLATE</i>			
DRILLERS REMARKS:			
<i>first well.</i>			

7-16-84
DW

If well telescopes please sketch and show depths.

GROUND LEVEL

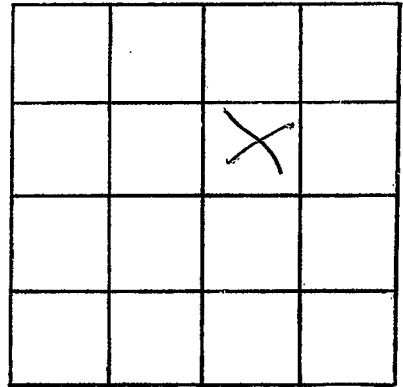

SECTION 10

Please indicate well location X.

ADDITIONAL INFORMATION

If more than one screen,
show locations of each on sketch.