

MISSISSIPPI DEPARTMENT OF NATURAL RESOURCES

Bureau of Land and Water Resources

Southport Mall

P.O. Box 10631

Jackson, Mississippi 39209

WATER WELL DRILLERS LOG

CODED

LEFLORE
B 65

3-2-86

date well completed

19

LeFlores Well Drilling
firm name

LEFLORE

county well located

LANDOWNER:

Parks Plant

description of formations encountered

from

to

P.O. Box 926

Shedden Miss

(mailing address) 39730

CLAY	0	15
FINE SAND	15	40
COARSE SAND	40	65
COARSE SAND / GRAVEL	65	90

WELL LOCATION:

sec. 9 T 22 N R 1 E
S W
3 miles N of Monticello
(distance) (direction) (nearest town)

WELL PURPOSE: PIVOT
(home, irrigation, municipal, industrial)

WELL COMPLETION DATA:

- (1) diameter (inches) 12"
- (2) total depth (feet) 90
- (3) static water level (feet) _____ below above top of ground.
- (4) casing Steel 50'
(material) (depth)
12" if telescope see back.
(size)
- (5) screen 40' 50'
(length) (depth to top)
12" steel
(size) (material)
- (6) pump 70 1400
(HP) (yield gpm)
DAL
(type power)
- (7) electric log no
(yes or no)

(organization running log) steel

(8) how well bottom plugged PIATE

DRILLERS REMARKS:


CODED

RECEIVED
AUG 26 1986

Department of Natural Resources
Bureau of Land & Water Resources

If well telescopes please sketch and show depths.

GROUND LEVEL

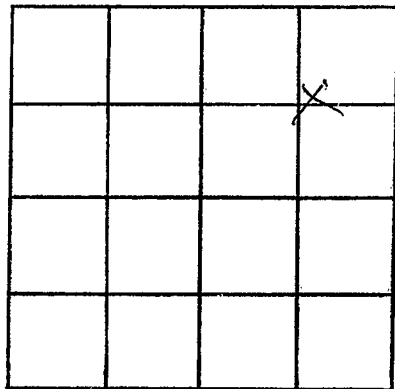

SECTION _____

Please indicate well location X.

ADDITIONAL INFORMATION

If more than one screen,
show locations of each on sketch.