

MISSISSIPPI DEPARTMENT OF NATURAL RESOURCES

Bureau of Land and Water Resources

Southport Mall

P.O. Box 10631

Jackson, Mississippi 39209

WATER WELL DRILLERS LOG

CODED

LEFLORE
B 66

3-3-86

date well completed

19 *LeFlores Well Drilling Co.*

firm name

LeFLORE

county well located

LANDOWNER:

Barb's Plant

description of formations encountered

from

to

P.O. Box 926

CLAY

0

10

FINE SAND

10

25

Chadman Miss

(mailing address) 39130

COARSE SAND / GRAVEL

25

69

WELL LOCATION:

sec. 10 T. 22 N. R. 1 E.

3 miles N of Monticello

WELL PURPOSE: Pivot
(home, irrigation, municipal, industrial)

WELL COMPLETION DATA:

(1) diameter (inches) 12"

(2) total depth (feet) 69'

(3) static water level (feet) _____ below above top of ground.

(4) casing steel (material), 29' (depth)

12" (size) if telescope see back.

(5) screen 40' (length), 29' (depth to top)

12" (size), steel (material)

(6) pump 70 (HP), 1400 (yield gpm)


Del (type power)

(7) electric log no. (yes or no)

(organization running log) steel

(8) how well bottom plugged plate

CODED

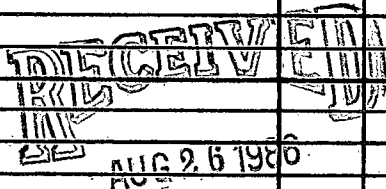


Department of Natural Resources
Bureau of Land & Water Resources

DRILLERS REMARKS:

If well telescopes please
sketch and show depths.

GROUND LEVEL

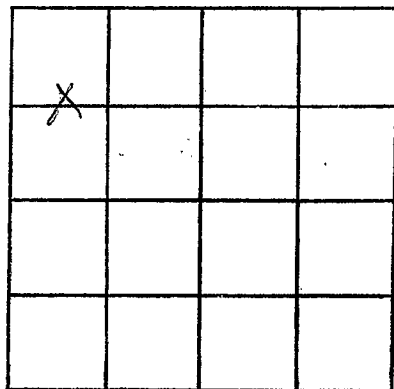

SECTION _____

Please indicate well location X.

ADDITIONAL INFORMATION

If more than one screen,
show locations of each on sketch.