

MISSISSIPPI DEPARTMENT OF NATURAL RESOURCES

Bureau of Land and Water Resources

Southport Mall

P.O. Box 10631

CODED

Jackson, Mississippi 39209

WATER WELL DRILLERS LOG

LEFLORE  
368

5-13-1987 BUTANE GAS CO. OF GREENWOOD Leflore  
date well completed firm name county well located

LANDOWNER:  
Roberson Plantation  
Minter City  
(mailing address)

description of formations encountered	from	to
CLAY	0	15
SAND	15	30
SAND & GRAVEL	30	94

WELL LOCATION:  
sec. 6 T 22 N R 1 E  
S  
4 1/2 miles N/E of Minter City  
(distance) (direction) (nearest town)

WELL PURPOSE: IRR  
(home, irrigation, municipal, industrial)

CODED

WELL COMPLETION DATA:

(1) diameter (inches) 16

(2) total depth (feet) 94

(3) static water level (feet) 20 below above top of ground.

(4) casing Steel 54 (material) (depth)  
16 (size) if telescope see back.

(5) screen 40 54 (length) (depth to top)  
16 Steel (size) (material)

(6) pump 31 700 (HP) (yield gpm)  
Diesel (type power)

(7) electric log No (yes or no)  
(organization running log)

(8) how well bottom plugged  
Steel Plate

RECEIVED


JUN 03 1987

Department of Natural Resources  
Bureau of Land & Water Resources

DRILLERS REMARKS:

If well telescopes please sketch and show depths.

GROUND LEVEL

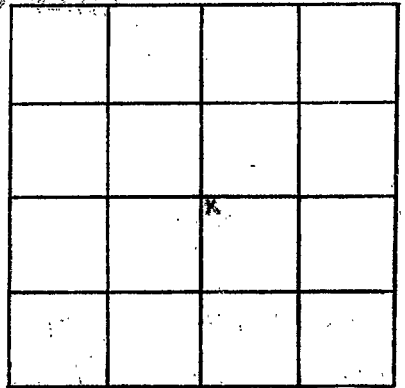

SECTION 6

Please indicate well location X.

ADDITIONAL INFORMATION

If more than one screen, show locations of each on sketch.