

**LEFLORE**  
**B69**

MISSISSIPPI DEPARTMENT OF NATURAL RESOURCES  
 Bureau of Land and Water Resources  
 Southport Mall  
 P.O. Box 10631  
 Jackson, Mississippi 39209 **CODED**  
**WATER WELL DRILLERS LOG**

5-24 1987 **BUTANE GAS CO. OF GREENWOOD** Le flore  
 date well completed firm name county well located

**LANDOWNER:** 5-20  
Roberson Plantation  
Minter City, Miss  
 (mailing address)

description of formations encountered	from	to
<u>CLAY</u>	<u>0</u>	<u>18</u>
<u>FINE SAND</u>	<u>18</u>	<u>50</u>
<u>PEA GRAVEL</u>	<u>50</u>	<u>75</u>
<u>GRAVEL</u>	<u>75</u>	<u>98</u>

**WELL LOCATION:**  
 sec. 7 T. 22 N. R. 1 E.  
4 miles N/E of Minter City  
 (distance) (direction) (nearest town)

**WELL PURPOSE:** FRR  
 (home, irrigation, municipal, industrial)

**WELL COMPLETION DATA:**

(1) diameter (inches) 12"

(2) total depth (feet) 98

(3) static water level (feet) 20 below above top of ground.

(4) casing Steel, 58  
 (material), (depth)  
12" if telescope see back.  
 (size)

(5) screen 40, 58  
 (length), (depth to top)  
12", Steel  
 (size), (material)

(6) pump 80, 1150  
 (HP), (yield gpm)  
Diesel  
 (type power)

(7) electric log NO  
 (yes or no)

(organization running log)

**CODED**

**RECEIVED**

**JUN 03 1987**


(8) how well bottom plugged Steel Plate

**DRILLERS REMARKS:**

Department of Natural Resources  
 Bureau of Land & Water Resources

If well telescopes please sketch and show depths.

GROUND LEVEL

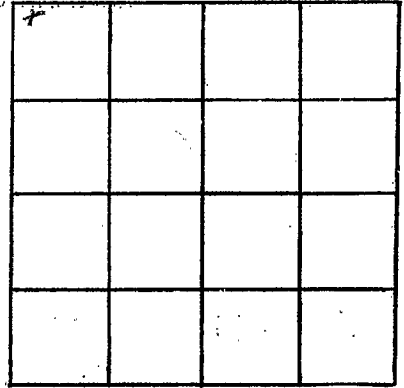

SECTION 7

Please indicate well location X.

ADDITIONAL INFORMATION

If more than one screen, show locations of each on sketch.