

Le flore

# MISSISSIPPI DEPARTMENT OF NATURAL RESOURCES

Bureau of Land and Water Resources

P.O. Box 10631

Jackson, Mississippi 39209

## WATER WELL DRILLERS LOG

COUNTY WELL LOCATED  
Tallahatchie

WELL NUMBER B 71 CODED

DATE WELL COMPLETED  
4-7-88

PERMIT NUMBER \_\_\_\_\_

NAME OF DRILLING FIRM  
**BUTANE GAS CO. OF GREENWOOD**

NAME & MAILING ADDRESS OF LANDOWNER  
Mike P. Sturdivant  
Glen Dora

WELL LOCATION: SEC 2 TOWNSHIP 22 RANGE 1  
NE 1/4 SW 1/4 N W

DISTANCE 2 1/2 Miles DIRECTION SE of NEAREST TOWN Glen Dora

OTHER LANDMARK \_\_\_\_\_

WELL PURPOSE: Home, Irrigation, Municipal, Industrial, Fish Pond, etc.

### PUMP DATA

PUMP TYPE (Circle One):  
Submersible, Turbine, Jet, Flowing Well,  
Other (Describe) \_\_\_\_\_

POWER TYPE (Circle One):  
Electric, Tractor, Diesel, Gasoline, Butane,  
Other (Describe) \_\_\_\_\_

Pump Capacity (GPM)	No. of Stages	Setting Depth
<u>600</u>	<u>1</u>	<u>60</u> FT.

PUMP TEST  
Well yielded \_\_\_\_\_ GPM with  
a drawdown of \_\_\_\_\_ ft.  
after \_\_\_\_\_ hours of pumping

### WELL DATA

Well Depth	Casing Diameter (In.)	Casing Length (Ft.)
<u>90</u>	<u>8</u>	<u>50</u>
Type of Casing	Hole Depth	Depth to Static Water Level
<u>PVC</u>	<u>90</u>	

TYPE OF COMPLETION: (Circle One or More):  
Gravel Packed, Underreamed, Telescoped,  
Natural Development, Open Hole, Other \_\_\_\_\_

Top of Lap Pipe or Reduction in Casing  
FEET \_\_\_\_\_ IF TELESCOPED OR MORE THAN ONE SCREEN: USE BACK PAGE

### LOG DATA

TYPE OF LOG RUN (Circle One):  
Electric, Gamma Ray, Density, Sonic, No Log Run, Neutron,  
Other (Describe) \_\_\_\_\_

Name of Organization Running Log \_\_\_\_\_

### SCREEN DATA

Diameter - Inches	Length - Feet	Slot Size - Inches
<u>8</u>	<u>40</u>	<u>.030</u>
Screen Type	Depth to Bottom - Feet	
<u>PVC - Slotted</u>	<u>90</u>	

### GEOLOGIC DATA (Office Use Only)

Surface Elev.	Geologic Unit	Unit Thickness	Depth to Top
Subs. SWL	Date	Analysis	Aquifer Test

Driller's Remarks \_\_\_\_\_

DESCRIPTION OF FORMATIONS ENCOUNTERED	FROM	TO	FORMATIONS (Continued)	
			FROM	TO
<u>Clay</u>	<u>0</u>	<u>20</u>		
<u>Sand</u>	<u>20</u>	<u>60</u>		
<u>Sand + Gravel</u>	<u>60</u>	<u>90</u>		


**RECEIVED**  
**APR 18 1988**

Department of Natural Resources  
Bureau of Land & Water Resources

IF MORE SPACE IS NEEDED, USE BACK

If well telescopes please sketch and show depths.

GROUND LEVEL

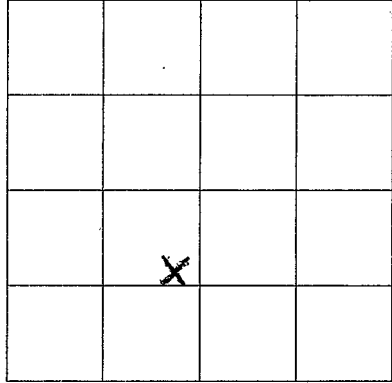

SECTION 2

Please indicate well location X.

ADDITIONAL INFORMATION

Lined area for providing additional information, consisting of approximately 25 horizontal lines.

If more than one screen, show location of each on sketch.