

MISSISSIPPI DEPARTMENT OF ENVIRONMENTAL QUALITY

Office of Land and Water Resources

P. O. Box 10631
Jackson, MS 39289-0631
WATER WELL DRILLERS LOG

COUNTY, WELL LOCATED
Leflore

WELL NUMBER **1** CODED

B-104

DATE WELL COMPLETED
6/10/02

PERMIT NUMBER
GW 38807

NAME OF DRILLING FIRM
ALford Frnig

NAME & MAILING ADDRESS OF LANDOWNER
Walter Pillow

PO-Box 202

Morgan City Miss. 38946

WELL LOCATION: SEC **22** TOWNSHIP **T22** RANGE **R1**

DISTANCE **1** Miles DIRECTION **N** NEAREST TOWN **Scampside**

OTHER LANDMARK

WELL PURPOSE: Home Irrigation Municipal, Industrial, Fish Pond, etc.

PUMP DATA

PUMP TYPE (Circle One):
Submersible, Turbine, Jet, Flowing Well,
Other (Describe)

POWER TYPE (Circle One):
 Electric, Tractor, Diesel, Gasoline, Butane,
Other (Describe) H/P **40**

Pump Capacity (GPM) **2200** No. of Stages **2** Setting Depth **60** FT.

PUMP TEST

Well yielded _____ GPM with
a drawdown of _____ ft.
after _____ hours of pumping

WELL DATA

Well Depth 120	Casing Diameter (In.) 16	Casing Length (Ft.) 80
Type of Casing PVC	Hole Depth 120	Depth to Static Water Level

TYPE OF COMPLETION: (Circle One or More):
 Gravel Packed, Underreamed, Telescoped,
Natural Development, Open Hole, Other

LOG DATA

TYPE OF LOG RUN (Circle One): No Log Run
Electric, Gamma Ray, Density, Sonic, Neutron,
Other (Describe)

Name of Organization Running Log

WELL GROUTED TO A DEPTH OF _____ FEET
Type Grout (circle one): Cement, Bentonite, or Mix

GEOLOGIC DATA (Office Use Only)

Surface Elev.	Geologic Unit	Unit Thickness	Depth to Top
Subs. SWL	Date	Analysis	Aquifer Test

SCREEN DATA

Diameter - Inches 16	Length - Feet 40	Slot Size - Inches 32
Screen Type Pvc	Depth to Bottom - Feet 120	

Driller's Remarks


DESCRIPTION OF FORMATIONS ENCOUNTERED	FROM	TO	FORMATIONS (Continued)	FROM	TO
CLAY	0	16			
FINE SAND	16	32			
SAND GRAVEL	32	120			

RECEIVED
FEB 18 2003
BY: OLWR

IF MORE SPACE IS NEEDED, USE BACK

If well telescopes please sketch and show depths.

GROUND LEVEL

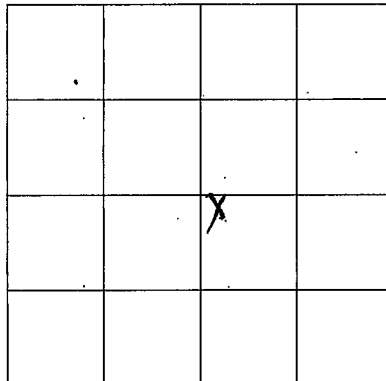

SECTION 22

Please indicate well location X.

ADDITIONAL INFORMATION

If more than one screen,
show location of each on sketch.