

**MISSISSIPPI DEPARTMENT OF ENVIRONMENTAL QUALITY**

Office of Land and Water Resources

COUNTY WELL LOCATED Leflore	
WELL NUMBER B-100	CODED
DATE WELL COMPLETED 4-17-03	

PERMIT NUMBER 6W40961
NAME OF DRILLING FIRM Irrigation Equipment Inc. Indianola, MS

P. O. Box 10631  
Jackson, MS 39289-0631  
**WATER WELL DRILLERS LOG**

NAME & MAILING ADDRESS OF LANDOWNER Ray Chacon 355 N. Ruby Ave. Ruleville, MS 38771	
--	--

Latitude:  
Longitude:

WELL LOCATION	SEC	TOWNSHIP	RANGE
NW/SE	18	22 <sup>N</sup> <sub>S</sub>	1W <sup>E</sup> <sub>W</sub>
DISTANCE	DIRECTION	NEAREST TOWN	
Miles	NW	Minter City	

OTHER LANDMARK

WELL PURPOSE: Home, Irrigation, Municipal, Industrial, Fish Pond, etc.  
Irrigation

**WELL DATA**

Well Depth 125	Casing Diameter (In.) 16	Casing Length (Ft.) 85
Type of Casing pvc	Hole Depth 125	Depth to Static Water Level 30ft.

TYPE OF COMPLETION: (Circle One or More):  
Gravel Packer, Underreamed, Telescoped,  
Natural Development, Open Hole, Other  
(Describe)

WELL GROUTED TO A DEPTH OF 10 FEET  
Type Grout (circle one): Cement, Bentonite or Mix

**SCREEN DATA**

Diameter - Inches 16	Length - Feet 40	Slot Size - Inches .050
Screen Type pvc		Depth to Bottom - Feet 125

**PUMP DATA**

PUMP TYPE (Circle One):  
Submersible, Turbine, Jet, Flowing Well,  
Other (Describe)

POWER TYPE (Circle One):  
Electric, Tractor, Diesel, Gasoline, Butane,  
Other (Describe) H/P 60

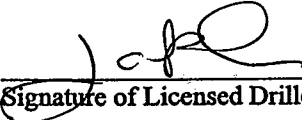
DESCRIPTION OF FORMATIONS ENCOUNTERED	FROM	TO
Clay	0	18
Fine Sand	18	45
Fine Sand/gravel	45	60
Med. Sand/gravel	60	125

**RECEIVED**  
**APR 24 2003**  
**BY: OLWR**

Top of Lap Pipe or Reduction in Casing

FEET	IF TELESCOPED OR MORE THAN ONE SCREEN: USE BACK PAGE
------	--

I certify that the well was drilled, constructed and completed in accordance with all applicable Requirements of the Mississippi Department of Environmental Quality and/or the Mississippi Department of Health regulations and state laws.


0439
4-21-03  
 Signature of Licensed Driller and License No. Date

Additional Information Required On Back

If well telescopes please sketch and show depths.

GROUND LEVEL

		X	

SECTION 18

Please indicate well location X.

Pump Capacity (GPM) 2500 to 3000	No. of Stages 1	Setting Depth 70 FT.
--	--------------------	-------------------------

PUMP TEST

Well yielded \_\_\_\_\_ GPM with  
a drawdown of \_\_\_\_\_ ft.  
after \_\_\_\_\_ hours of pumping

**LOG DATA**

TYPE OF LOG RUN (Circle One): No Log Run, Electric, Gamma Ray, Density, Sonic, Neutron, Other (Describe) \_\_\_\_\_

Name of Organization Running Log \_\_\_\_\_

**GEOLOGIC DATA (Office Use Only)**

Surface Elev.	Geologic Unit	Unit Thickness	Depth to Top
Subs. SWL	Date	Analysis	Aquifer Test

Driller's Remarks

---



---



If more than one screen, show location of each on sketch.