	State Well	Report	
County: Leflore	Part 1		For Office Use Only:
	Mississippi Department of		Aquifer:
Pamit#:	Office of Land and V		Well #: B - 1/4
Driller:	P.O. Box 10631		
Date drilling completed: 3-3-05	Jackson, MS 3 (601)961-		L. S. Elevation:
Zuc drining compact.	(601)354-69		E-log #:
	•	, ,	
State Law requires that this rep 30 days of completion of drilling	of the well.	ller in detail and filed wi	ith the Department within
Well Owner Informa	tion	Well	Location
Owner Name David Smit	h Is	titude. $33 + 4 + 16$ N	"Longitude: 90,21,5%"
· · · · · · · · · · · · · · · · · · ·	ce Road 5470	45 Ol	"Longitude: 90 21, 5\", 0 e): Conventional Survey,
		USGS quad, Hand-held	GPS, Survey-grade GPS
Alicia, AR	72410 . N	E 14 NE 14 Sec 30	Twn 22N Rng 1W
	te Zip Code		
870-886-2801 Telephone No. ()	Di	stance Direction 3 Miles West	Nearest Town of Minter City
·	Well Data	- <u>-</u>	
Purpose of Well (circle one) Home Ind	ustrial Public Supply (Irr	rigation) Fish Culture	Other:
Date well drilling started: $3-3-0.5$			
If flowing, method of flow regulation: Va	lve Other (descr	ibe)	
Static Water Level:feet at	ove or below (circle one) land	surface Date measured:_	
Method of Measurement (circle one)	teel tape electric tape	air line other:	
Hole depth: 117' Well de	pth:	Well grouted to a depth of _	1 0feet
	Mix Mix		
Casing length: 77 feet Casi	ng diameter: 16 in	ches Type of casing:	PVC Sch.40
Screen length: 40 feet Screen	en diameter: 16i	nches Type of screen:	PVC Sch.40
Screen slot size:inches	Setting depth: From		117 feet
Type of completion (circle all applicable):	Gravel packed Underream	ned Telescoped Open	hole Natural Development
•	Other (describe):		
Top of lap pipe or reduction in casing:	feet. If teleso	oped or more than one scr	een, describe on back of page
Logs run (circle all applicable): No log ru	n) Electric Gamma Ray D	ensity Sonic Neutron	Other:
Name of organization running log(s):	•		· · · 1
I certify that the well was drilled, constr		rdance with all applicable	requirements of the Mississippi
Department of Environmental Quality a Irrigation Equi	nd/or the Mississippi Departu pment Inc.		1
Patrick M. Chis	m 0695 .	V+I	mal.

Part 1 mailed 3-29-05.

Print Name of Water Well Contractor and License No.

MAR 3 1 2005


Signature of Water Well Contractor
RECEIVED

BY: OLWR

Ground Level B - 114

Description of Formations Encountered	From	To
Clay	10	30
Fine Sand	31	4.5
Fine Sand/Gravel	46	55
Med. Sand/Gravel	56	117
	1	
	—	
	1	
	1	
·	<u> </u>	
	1	

If more than one screen, show location of each on sketch

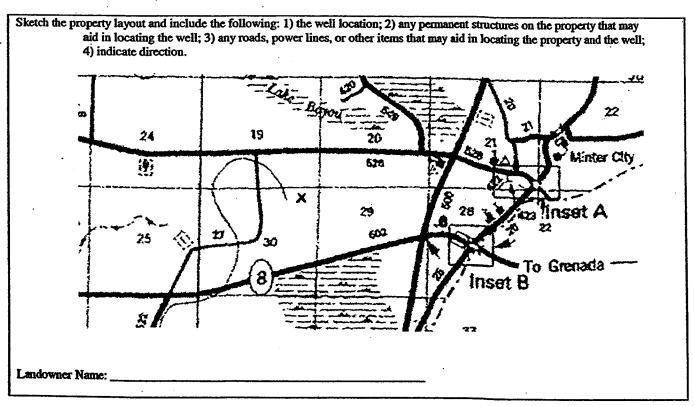

Signature of Water Well Contractor

STATE WELL REPORT

Part 2

County: Leflore

Permit#:
Irrigation Equipment
Driller:

Date completed: 4-4-05

Pump Installer's Completion Report
Mississippi Department of Environmental Quality
Office of Land and Water Resources
P.O. Box 10631
Jackson, MS 39289-0631
(601)961-5210
(601)354-6938 (fax)

For Office Use Only:				
Aquifer:	R- X-			
Well #:	7 475			
Elevation: _				

	Well Owner Inform		Well Location	- gov
)wner Name:	David Smith		Latitude: Longitude:	
failing Address:	51 Lawrenc	e Road 5470	Method of Lat/Long (circle one): Conventional Survey, Al	P
			USGS quad, Hand-held GPS, Survey-grade	\$ (
Ā	Alicia, AR	72410	NE 1/4 NE 1/4 Sec 30 Twn 22N Rng 1W	
ī	City State	; Zip Code	Distance Direction Nearest Town	_
	⁷⁰ -886-2801		3 West Minter Cityof	_
-	Pump Type Circle one		Power Type Circle one	
Air Lift	Jet	Submersible	Desel Engine Gasoline Engine Natural G	ias
Bucket	Piston	Turbine	Electric Motor Hand Tractor P	O
Centrifugal	Rotary	Flowing Well	Windmill Other (specify):	_
Other (specify):			Horse Power Rating of Motor: 60	_
	d: 4-4-0		Setting Depth: 60 feet	
Rated Pump Capac	2500-3000 ity:	Gallons Per Minute	Number of Stages:1	
	Pump Test Dat	ta .	Method of Measuring Water Level Circle one	
Date Well Tested:			Air Line Electric Measuring Line Steel Tape	;
Static Water Level	(A): <u>29 '</u> Fo	eet Below Land Surface	Other (specify):	
Pumping Water Le	vel (B):Fe	et Below Land Surface	Outer (Specify).	_
Drawdown [(B) – (A)]:Fe	eet Below Land Surface	For flowing well, measured shut in head:fe	æt
Test Pumping Rate	:	Gallons Per Minute	Well yieldedGPM with a drawdown of	
			feet afterhours of pump	ing
Duration of Pump	Tope (minimum . no-			

Part 1 mailed 3-39-05.

Water level has been added.