County: Lef1	Leflore				
Permit#: 6W 40937 Irrigation Equipment Driller:					
Date drilling completed:	3-9-06				

## **State Well Report**

## Part 1

Mississippi Department of Environmental Quality
Office of Land and Water Resources
P.O. Box 10631
Jackson, MS 39289-0631
(601)961-5210
(601)354-6938 (fax)

For Office Use Only:
Aquifer:
Well #: 8 - 3
L. S. Elevation:
E-log #:


State Law requires that this report be prepared by the driller in detail and filed with the Department within 30 days of completion of drilling of the well.

30 days of completion of drilling of the well.					
Well Owner Information	Well Location				
Owner Name Ray Chacon	Latitude: 33 46 52.3N 90 20 0,0.0W				
Mailing Address: 355 North Ruby Ave	Method of Lat/Long (circle one): Conventional Survey,				
	USGS quad, Hand-held GPS, Survey-grade GPS				
	NW <sub>1/4</sub> _NE 1/4 Sec_18Twn_22NRng_1W				
Ruleville MS 38771 City State Zip Code	Distance Direction Nearest Town 4 Miles NW of Minter City				
Telephone No. (	•				
Well I	Data				
Purpose of Well (circle one) Home Industrial Public Supply	Inigation Fish Culture Other:				
Date well drilling started: 3-9-06 Date v	well drilling completed: <u>3-9-06</u>				
If flowing, method of flow regulation: Valve Other (d	escribe)				
Static Water Level: 32 feet above or below (circle one) l	and surface Date measured: 3-14-06				
Method of Measurement (circle one) steel tape electric tape	air line other:				
Hole depth: 121 Well depth: 121' Well grouted to a depth of 10 feet					
Type of grout (circle one): Cement Bentonite Mix					
Casing length: 81 feet Casing diameter: 16	inches Type of casing: PVC Sch. 40				
Screen length: 40 feet Screen diameter: 16	inches Type of screen: PVC Sch. 40				
Screen slot size:050 inches Setting depth: From	82feet to <u>121feet</u>				
Type of completion (circle all applicable): Gravel packed Under	reamed Telescoped Open hole Natural Development				
Other (describe):					
Top of lap pipe or reduction in casing:feet. If telescoped or more than one screen, describe on back of page					
Logs run (circle all applicable): No log run Electric Gamma Ray Density Sonic Neutron Other:					
Name of organization running log(s):					
I certify that the well was drilled, constructed, and completed in accordance with all applicable requirements of the Mississippi					
Department of Environmental Quality and/or the Mississippi Department of Health regulations and state laws.					
Irrigation Equipment Inc. Patrick M. Chism 0695	Patro M Cha				
Print Name of Water Well Contractor and License No.  Signature of Water Well Contractor					

Ground Bevel

Description of Formations Encountered	From	To_
Clav	0	_28
Fine Sand	29	4.0
Fine Sand/gravel	41	55
Fine Sand/gravel Med. Sand/gravel	56	121
		1
		<b>  </b>
		<b>↓</b> ——
		1
		$\vdash$
		11
		1
		$\vdash$
		$\vdash$
		+
		<b>↓</b>
		1
		<del>  </del>
		+-
		$oldsymbol{\perp}$

If more than one screen, show location of each on sketch

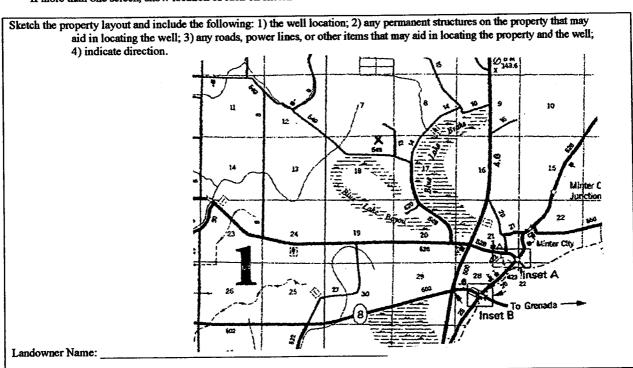

Signature of Water Well Contractor

## STATE WELL REPORT

## Part 2

**Pump Installer's Completion Report** Mississippi Department of Environmental Quality Office of Land and Water Resources P.O. Box 10631 Jackson, MS 39289-0631 (601)961-5210

For Office Use Only:		
Aquifer:		
Well#: <b>B-13</b>   Elevation:		

Couv information from block on Part 1

Irrigation Equipment

County: Leflore

Date completed: 3-9-06

Permit #: 6 W 40937

Copy information from block on Part 1	(601)35	4-6938 (fax)	Elevation:	tion:		
This part of the report must be completed by a licensed water well contractor or a licensed pump installer. A copy of Part 1 of the report must be attached and both parts filed with the Department at the above address within 30 days of well completion.						
Well Owner Informati	tion	W	ell Location			
Owner Name: Ray Chacon		Latitude:	Longitude:			
Mailing Address: 355 North R	Suby Ave	Method of Lat/Long (check one): Conventional Survey,				
		USGS quad, Hand-he	ld GPS, Survey	-grade GPS		
Ruleville,		¼¼ Sec 18_T_22N_R_1W_				
City State		Distance Direction	Nearest Tov	/n		
662-756-4119 Telephone No. ()		4 Miles NW of Minter City				
Pump Type		Power Type				
Circle one			Circle one			
Air Lift Jet	Submersible	Desel Engine Gaso	line Engine	Natural Gas		
Bucket Piston	urbine	Electric Motor Hand	i	Tractor PTO		
Centrifugal Rotary	Flowing Well	Windmill Othe	r (specify):			
Other (specify):		Horse Power Rating of Motor: 40				
Date Pump Installed: 3-14-06		Setting Depth: 60 feet		feet		
Rated Pump Capacity: 1800	Gallons Per Minute	Number of Stages: 2				
Pump Test Data	Pump Test Data Method of Measuring Water Level					
-			Circle one			
Date Well Tested:		Air Line Electric Me	easuring Line	Steel Tape		
	Level (A):Feet Below Land Surface Other (specify):					
Pumping Water Level (B):Feet	Below Land Surface					
Drawdown [(B) - (A)]:Feet	Below Land Surface	For flowing well, measured	shut in head:	feet		
Test Pumping Rate:	Gallons Per Minute	Well yieldedGPM with a drawdown of				
Duration of Pump Test (minimum 4 hours):	hours	feet afterhours of pumping				
	2	$\overline{}$				
I HEREBY CERTIFY that the above statements are true to the best of my knowledge.						
Patrick M. Chism 0695 Print Name of Pump Installer and License No. (if applicable)  Signature of Pump Installer						
FIRE Name of rump Installer and License N	io. (ii applicable)	8 Signature of Pump		OLIMP SIMP 1B		

Form: OLWR-SWR-1B

RECEIVED

MAR 27 2006

BY: OLWR