County: Leflor	re	
Permit#: 0W 4 Irrigation Driller:	1084 Equipmen	t
Date drilling completed:	5-20-06	5

State Well Report

Part 1

Mississippi Department of Environmental Quality
Office of Land and Water Resources
P.O. Box 10631
Jackson, MS 39289-0631
(601)961-5210
(601)354-6938 (fax)

For Office Use Only:
Aquifer:
Well #: 123
L. S. Elevation:
E-log #:


State Law requires that this report be prepared by the driller in detail and filed with the Department within 30 days of completion of drilling of the well.

30 days of completion of drilling of the well.					
Well Owner Information	Well Location				
Owner NameBlue_Lake_Farms	Latitude: 33, 45, 13.4 Longitude: 90, 20, 19.0				
Mailing Address: c/o Gary Reynolds	Method of Lat/Long (circle one): Conventional Survey,				
3120 Stagecoach Trail	USGS quad, Hand-held GPS, Survey-grade GPS				
	<u>SW 1/4 Se 1/4 Sec 19 Twn 22N Rng 1W</u>				
Wimauma FL 33598 City State Zip Code	Distance Direction Nearest Town 2 Miles West of Minter City				
Telephone No. ()					
Well I	Data				
Well					
Purpose of Well (circle one) Home Industrial Public Supply	Perigation Fish Culture Other:				
Date well drilling started: 5-20-06 Date w	vell drilling completed: 5-20-06				
If flowing, method of flow regulation: Valve Other (de	escribe)				
Static Water Level:31 'feet above or below (circle one) l	and surface Date measured: 5-22-06				
Method of Measurement (circle one) steel tape electric tape	air line other:				
Hole depth: 115 Well depth: 115 Well grouted to a depth of 10 feet					
Type of grout (circle one): Cement Bentonite Mix	*				
Casing length: 75 feet Casing diameter: 16	_inches Type of casing: _Sch.40				
Screen length: 40 feet Screen diameter: 16	_inches Type of screen:Sch.40				
Screen slot size:inches Setting depth: From _	76feet to115feet				
Type of completion (circle all applicable): Gravel packed Under	reamed Telescoped Open hole Natural Development				
Other (describe):					
Top of lap pipe or reduction in casing:feet. If telescoped or more than one screen, describe on back of page					
Logs run (circle all applicable): No log run Electric Gamma Ray Density Sonic Neutron Other:					
Name of organization running log(s):					
I certify that the well was drilled, constructed, and completed in accordance with all applicable requirements of the Mississippi					
Department of Environmental Quality and/or the Mississippi Department of Health regulations and state laws,					
Irrigation Equipment Inc. Patrick M. Chism 0695	Pahr M Chin				
Print Name of Water Well Contractor and License No.	Signature of Water Well Contractor				

Ground Level

Description of Formations Encountered	From	То
Clay	0	28
Fine Sand Fine Sand/gravel Med. Sand/gravel	29	35
Fine Sand/gravel	36	46
Med. Sand/gravel	47	115
	<u> </u>	\vdash
	ļ	
		
	 	
	<u> </u>	<u> </u>
		
	ļ.——	
	 	
	 	
	-	
	 	
	-	
	 	
	<u> </u>	

If more than one screen, show location of each on sketch

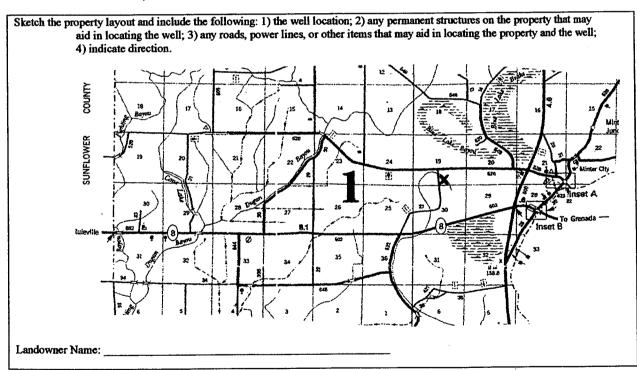

Signature of Water Well Contractor

STATE WELL REPORT

Part 2

County: Leflore

Permit #: CUUICSU

Irrigation Equipment

Driller:

Date completed: 5-20-06

Pump Installer's Completion Report
Mississippi Department of Environmental Quality
Office of Land and Water Resources
P.O. Box 10631
Jackson, MS 39289-0631
(601)961-5210

For Office Use Only:		
Aquifer:		
Well #: B - 123		
Elevation:		

Copy information from block on Part 1	(601)35	4-6938 (fax)	Elevation	n:
This part of the report must be completed by report must be attached and both parts filed v	with the Department a			
Well Owner Information			Well Location	l
Owner Name: Blue Lake Farms		Latitude:	Longitud	e:
Mailing Address: c/o Gary Reyn	olds	Method of Lat/Lon	g (check one): Conve	entional Survey,
3120 Stagecoa	ch Trail	USGS quad, Hand-held GPS, Survey-grade GPS		
Wimauma FL		sw 4 se 4 sec 19 T 22N R 1W		
City State	Zip Code	Distance I	Direction Neare	st Town
Telephone No. ()		2 Wes Miles	st Mint	er City
Pump Type Circle one			Power Type Circle one	
Air Lift Jet Su	ubmersible	Diesel Engine	Gasoline Engine	Natural Gas
Bucket Piston Tu	arbine	Lectric Moto	Hand	Tractor PTO
Centrifugal Rotary FI	lowing Well	Windmill	`` ''	
Other (specify):	· · · · · ·	Horse Power Ratin	g of Motor: 60	
Date Pump Installed: 5-22-06		Setting Depth:	60	feet
Rated Pump Capacity: 2500-3000 Gal	llons Per Minute	Number of Stages:		and the state of t
Pump Test Data		Met	hod of Measuring W Circle one	ater Level
Date Well Tested:				
Static Water Level (A):Feet Bel	ow Land Surface		ectric Measuring Lin	•
Pumping Water Level (B):Feet Belo	ow Land Surface	Other (specify):		
Drawdown [(B) - (A)]:Feet Belo	ow Land Surface	For flowing well, n	neasured shut in head	feet
Test Pumping Rate:Gal	llons Per Minute	Well yielded	GPM w	ith a drawdown of
Duration of Pump Test (minimum 4 hours):	hours		feet after	hours of pumping
I HEREBY CERTIFY that the above statements Patrick M. Chism Print Name of Pump Installer and License No. (0695	f my knowledge f	of Pump Installer	

Form: OLWR-SWR-1B

RECEIVED

JUN 0 1 2006

BY: OLWR