

# State Well Report

## Part 1

Mississippi Department of Environmental Quality  
Office of Land and Water Resources  
P.O. Box 10631  
Jackson, MS 39289-0631  
(601)961-5210  
(601)354-6938 (fax)

For Office Use Only:

Aquifer: \_\_\_\_\_  
Well #: B-129  
L. S. Elevation: \_\_\_\_\_  
E-log #: \_\_\_\_\_

County: Leflore  
Permit #: BW42363  
Driller: Irrigation Equipment  
Date drilling completed: 2-20-08

State Law requires that this report be prepared by the driller in detail and filed with the Department within 30 days of completion of drilling of the well.

Well Owner Information	Well Location
Owner Name: <u>New Hope Farms</u>	Latitude: <u>33° 47.12.0</u> Longitude: <u>90° 18.54.3</u>
Mailing Address: <u>c/o Wayne Bush</u>	Method of Lat/Long (circle one): <u>12</u> Conventional Survey, <u>54</u>
<u>49665 County Rd. 559</u>	USGS quad/Hand-held GPS, Survey-grade GPS <input checked="" type="checkbox"/>
<u>Schlater Ms. 38952</u>	<u>NE</u> 1/4 <u>SE</u> 1/4 Sec <u>8</u> Twn <u>22N</u> Rng <u>1W</u>
City State Zip Code	Distance Direction Nearest Town
Telephone No. <u>(602) 658-1166</u>	<u>2</u> Miles <u>NW</u> of <u>Winter City</u>

Well Data old well 10' south

Purpose of Well (circle one) Home Industrial Public Supply Irrigation Fish Culture Other Replacement

Date well drilling started: 2-20-08 Date well drilling completed: 2-20-08

If flowing, method of flow regulation: Valve \_\_\_\_\_ Other (describe) \_\_\_\_\_

Static Water Level: 31 feet above or below (circle one) land surface Date measured: 2-20-08

Method of Measurement (circle one) steel tape electric tape air line other: \_\_\_\_\_

Hole depth: 127 Well depth: 127 Well grouted to a depth of 10 feet

Type of grout (circle one): Cement Bentonite Mix

Casing length: 87 feet Casing diameter: 16 inches Type of casing: PVC

Screen length: 40 feet Screen diameter: 16 inches Type of screen: PVC

Screen slot size: .050 inches Setting depth: From 88 feet to 127 feet

Type of completion (circle all applicable): Gravel packed Underreamed Telescoped Open hole Natural Development

Other (describe): \_\_\_\_\_

Top of lap pipe or reduction in casing: \_\_\_\_\_ feet. If telescoped or more than one screen, describe on back of page

Logs run (circle all applicable): No log run Electric Gamma Ray Density Sonic Neutron Other: \_\_\_\_\_

Name of organization running log(s): \_\_\_\_\_

RECEIVED  
FEB 27 2008  
BY: OLWR

I certify that the well was drilled, constructed, and completed in accordance with all applicable requirements of the Mississippi Department of Environmental Quality and/or the Mississippi Department of Health regulations and state laws.

Patrick M. Chism 0695 \_\_\_\_\_  
Print Name of Water Well Contractor and License No. Signature of Water Well Contractor



# STATE WELL REPORT

## Part 2

**Pump Installer's Completion Report**  
 Mississippi Department of Environmental Quality  
 Office of Land and Water Resources  
 P.O. Box 10631  
 Jackson, MS 39289-0631  
 (601)961-5210  
 (601)354-6938 (fax)

County: Leflore  
 Permit #: \_\_\_\_\_  
 Driller: Irrigation Equipment  
 Date completed: 2-20-08

For Office Use Only:

Aquifer: \_\_\_\_\_  
 Well #: B-129  
 Elevation: \_\_\_\_\_

This report should be prepared by the pump installer in detail and filed with the Department within 30 days of the installation of pump.

Well Owner Information	Well Location
Owner Name: <u>New Hope Farms</u>	Latitude: _____ Longitude: _____
Mailing Address: <u>C/o Wayne Bush</u> <u>49665 County Rd 559</u> <u>Schlater Ms. 38952</u> <span style="display: block; text-align: center; font-size: small;">City State Zip Code</span>	Method of Lat/Long (circle one): Conventional Survey, USGS quad, Hand-held GPS, Survey-grade GPS <u>NE ¼ SE ¼ Sec 8 Twn 22N Rng 1W</u>
Telephone No. <u>662 658-1166</u>	Distance Direction Nearest Town <u>2 Miles NW of Minter City</u>

Pump Type Circle one	Power Type Circle one
Air Lift Jet Submersible	Diesel Engine Gasoline Engine Natural Gas
Bucket Piston <u>Turbine</u>	<u>Electric Motor</u> Hand Tractor PTO
Centrifugal Rotary Flowing Well	Windmill Other (specify): _____
Other (specify): _____	Horse Power Rating of Motor: _____ <u>40</u>
Date Pump Installed: <u>2-20-08</u>	Setting Depth: <u>70</u> feet
Rated Pump Capacity: <u>1800</u> Gallons Per Minute	Number of Stages: <u>2</u>

RECEIVED  
 FEB 27 2008  
 BY: OLWR

Pump Test Data	Method of Measuring Water Level Circle one
Date Well Tested: _____	Air Line Electric Measuring Line Steel Tape
Static Water Level (A): _____ Feet Below Land Surface	Other (specify): _____
Pumping Water Level (B): _____ Feet Below Land Surface	For flowing well, measured shut in head: _____ feet
Drawdown [(B) - (A)]: _____ Feet Below Land Surface	Well yielded _____ GPM with a drawdown of _____ feet after _____ hours of pumping
Test Pumping Rate: _____ Gallons Per Minute	
Duration of Pump Test (minimum 4 hours): _____ hours	

I HEREBY CERTIFY that the above statements are true to the best of my knowledge.

Patrick M. Chism 0695 \_\_\_\_\_  
 Print Name of Pump Installer and License No. (if applicable) Signature of Pump Installer

# New Hope Farms Map

R 2 W


R 1 W

B-129

TALLAHATCHIE COUNTY

LEFLORE ROAD INDEX

- 1 A1
- 2 A1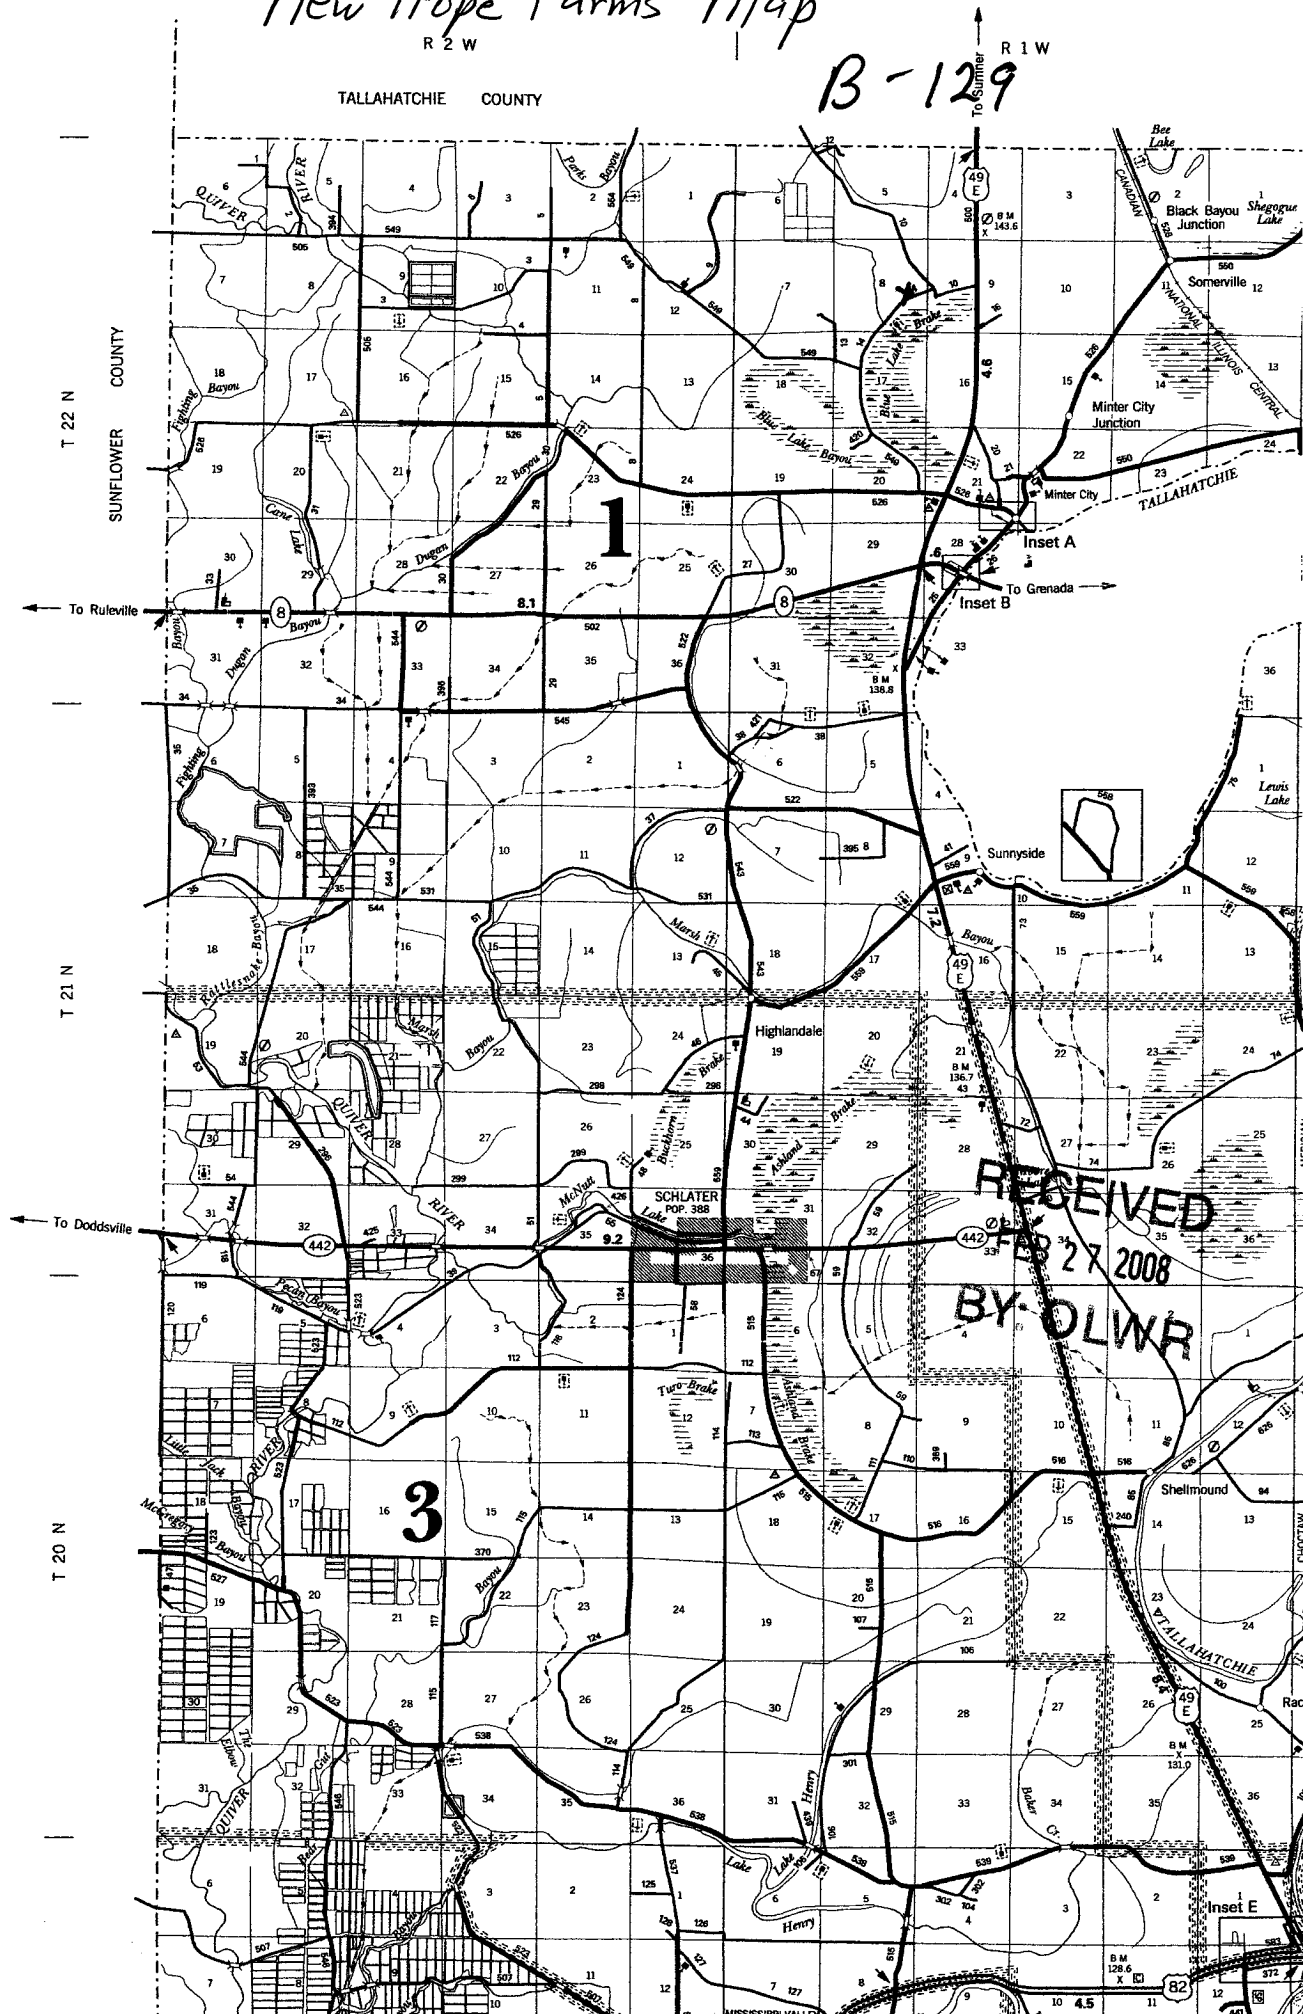
RECEIVED  
FEB 27 2008  
BY DLWR