

STATE WELL REPORT

Part 1

Driller's Log

Mississippi Department of Environmental Quality
Office of Land and Water Resources
P.O. Box 2309
Jackson, MS 39225-2309
(601)961-5210
(601)360-0535 (fax)

For Office Use Only:

Well #: B 143
Aquifer:
E-Log #:

County: Leflore
Permit #: MS-GW-49185
Driller:
Date drilling completed: 9-17-16

State Law requires that this report be prepared by the license holder responsible for the work and filed with the Department at the above address within 30 days of completion of drilling of the well or borehole.

Well Owner Information (Landowner if borehole is not for a water well)
Owner Name: Frank P. Steinboeck
Mailing Address: 208 West Harding Ave. Greenwood MS 38930
City State Zip Code
Telephone No.
Well or Borehole Location
Latitude: 33° 47' 6.02" N Longitude: 90° 10' 32.25" W
Method of Lat/Long (check one): Conventional Survey
USGS quad, Hand-held GPS X, Survey-grade GPS
NW 1/4 SE 1/4, Sec 10 T 22 N R 01 E
3 Miles NW of Phillip
(Distance) (Direction) (Nearest Town)

Well / Borehole Data
Date drilling started: 9/17/16 Date drilling completed: 9/17/16 Hole depth: 115 Hole diameter: 22
Location of the source of any surface water used for drilling:
Method of dosing and volume of Chlorine used in drilling and development:
Logs run (circle all applicable): No log run Electric Gamma Ray Density Sonic Neutron Other:
Name of organization running log(s):
Purpose of borehole (circle one): Water Well Geotechnical/Geological Investigation Ground Source Heat Pump
Seismic Survey Other (describe)
If drilling is not related to water well construction, skip the remainder of this block
Purpose of Well (circle all applicable): Home Industrial Public Supply Irrigation Fish Culture
Other (describe):
If a flowing well, method of flow regulation: Valve Other (describe)
Static Water Level: 18 feet [above or below] land surface Date measured:
(circle one)
Method of measurement (circle one): Steel tape Electric tape Air line Other (describe):
Well depth: 115 Well grouted to a depth of: 10 feet Type of grout (circle one): Neat Cement Bentonite Mix
Casing length: 75 feet Casing diameter: 12 inches Type of casing: PVC
Screen length: 40 feet Screen diameter: 12 inches Type of screen: PVC
Screen slot size: .032 inches Setting depth: From 75 feet to 115 feet
Type of completion (circle all applicable): Gravel packed Underreamed Open hole Natural Development
Other (describe):
Top of lap pipe or reduction in casing: feet
If telescoped or more than one screen, describe on next page

RECEIVED


OCT 17 2016

Form: OLWR-SWR-1A (4/13)


BY OLWR



B143

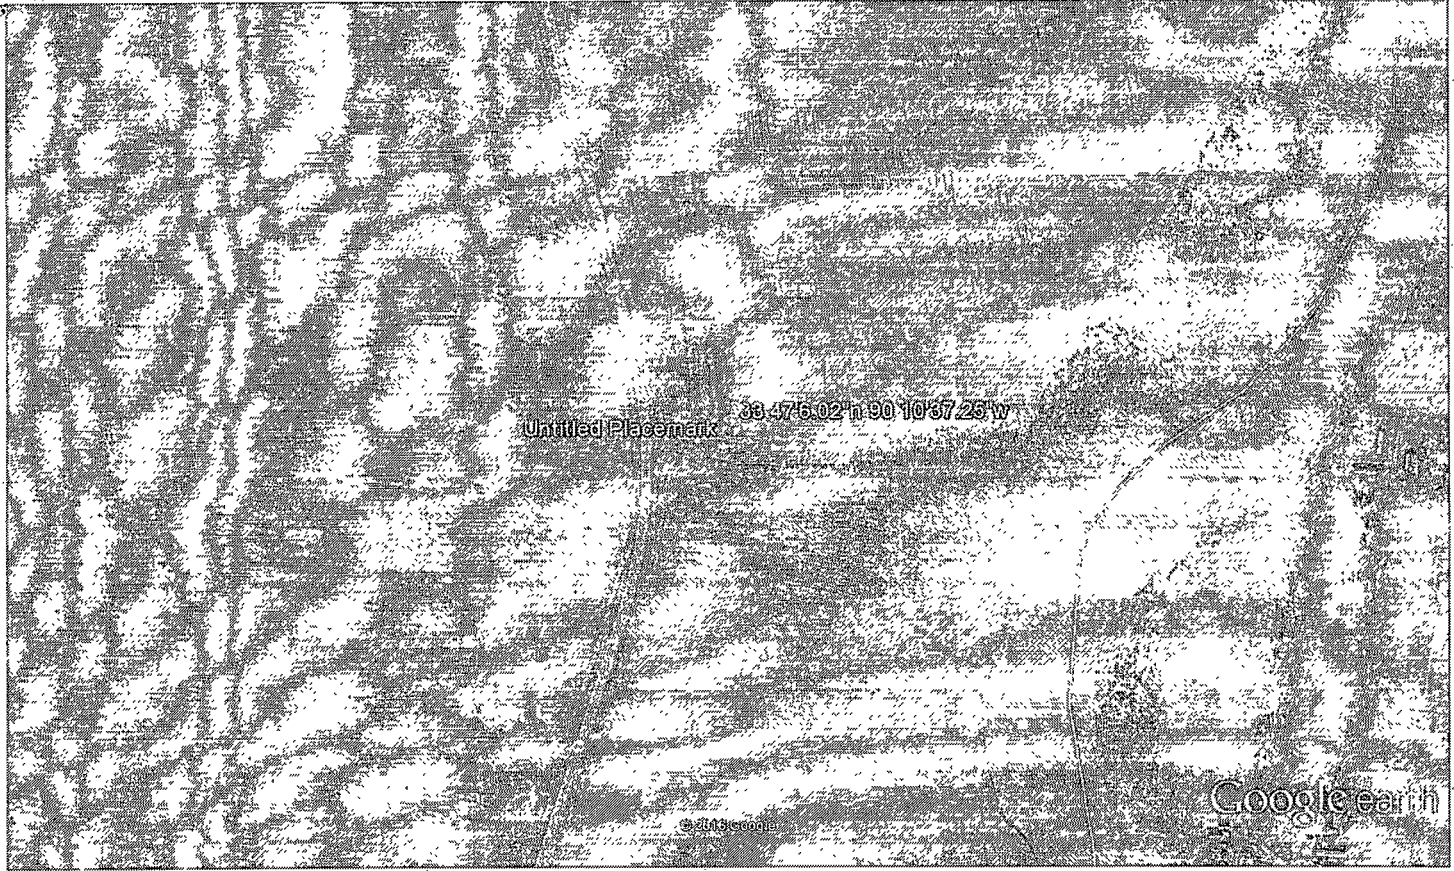

Google earth

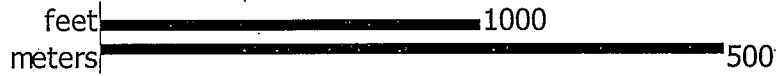

RECEIVED  
OCT 17 2016  
BY OLWR

STATE OF MISSISSIPPI  
Department of Environmental Quality  
Office of Land and Water Resources  
P. O. Box 2309  
Jackson, Mississippi 39225

B143

PERMIT

TO DIVERT OR WITHDRAW FOR BENEFICIAL USE THE PUBLIC WATERS

This permit is issued to the landowner named below in accordance with the provisions of the Mississippi Water Laws, Mississippi Code Sections 51-3-1, et seq. (1972, as amended), and the regulations and standards as promulgated thereunder. Whether or not specifically named in this permit or in the applications for this permit, anyone using water from the diversion/withdrawal point described below shall do so in compliance with the provisions of this permit. Neither this permit, nor any authority conferred hereby, may be sold, conveyed, encumbered, assigned, or otherwise aliened, for any period of time or under any conditions whatsoever. This permit may not be modified, transferred or revoked without prior action by the Permit Board. Any attempts to modify, transfer or revoke this permit, or to take any other action on this permit, shall be invalid and unenforceable and may result in immediate revocation or suspension of this permit. The holder of this permit shall at all times be responsible for adherence to the terms and conditions of this permit. No agreement between the permit holder and any other party shall affect the obligations and liabilities of the permit holder. Water use under this permit is allowed only when the streamflow, lake level elevation, or static groundwater level (whichever, if any, is applicable) is above the established minimum, pursuant to Mississippi Code Section 51-3-7. Authorization is hereby granted to divert/withdraw water for the beneficial use designated herein, and for no other purpose, subject to the following terms, conditions, and limitations:

Permit Number: MS-GW-49185

Landowner Name: STAINBACK, FRANK P, ET AL

Landowner Address: 208 WEST HARDING AVENUE  
GREENWOOD MS 38930

Source Of Water: MISSISSIPPI RIVER VALLEY ALLUVIAL AQUIFER

Beneficial Use: IRRIGATION

Diversion/Withdrawal Location: NW 1/4 of the SE 1/4 Section: 10 Township: 22N Range: 01E

County: LEEFLORE Quad: PHILIPP

Maximum Volume: 113 Acre-Foot/Year equivalent to .1009 Million Gallons/Day

Maximum Rate: 1000 Gallons/Minute

Applicant Name: BEULAH PLANTING COMPANY

Applicant Address: PO BOX 9  
SCHLATER MS 38952

Date Permit Issued: 12/02/2015

Date Permit Expires: 12/02/2020

Date Permit Modified:

Date Permit Re-issued:

This permit shall be deemed null and void if construction has not begun within one (1) year of permit issue date

SPECIAL TERMS AND CONDITIONS: SEE ATTACHMENT 1, WHICH IS HEREBY DECLARED TO BE PART OF THIS PERMIT.

SPECIAL TERMS AND CONDITIONS 2:

RECEIVED

OCT 17 2016

BY OLWR

Gary C. Rikard, Executive Director  
Mississippi Department of Environmental Quality