

STATE WELL REPORT

Part 1

Driller's Log

Mississippi Department of Environmental Quality
Office of Land and Water Resources
P.O. Box 2309
Jackson, MS 39225-2309
(601)961-5210
(601)360-0535 (fax)

For Office Use Only:

Well #: B144
Aquifer: _____
E-Log #: _____

County: Waltham
Permit #: MS-GW-49186
Driller: _____
Date drilling completed: 9-17-16

State Law requires that this report be prepared by the license holder responsible for the work and filed with the Department at the above address within 30 days of completion of drilling of the well or borehole.

Well Owner Information <small>(Landowner if borehole is not for a water well)</small>	Well or Borehole Location
Owner Name: <u>Rufus P. Steinback</u>	Latitude: <u>33°45'55.85" N</u> Longitude: <u>90°13'8.84" W</u>
Mailing Address: _____	Method of Lat/Long (check one): Conventional Survey _____,
<u>P.O. Box 85</u>	USGS quad _____, Hand-held GPS <u>X</u> , Survey-grade GPS _____
<u>Minter City MS 38944</u>	<u>SW</u> ¼ <u>SW</u> ¼, Sec <u>17</u> T <u>22N</u> R <u>O1E</u>
City _____ State _____ Zip Code _____	<u>3</u> Miles <u>NW</u> of <u>Phillip</u>
Telephone No. (____) _____	(Distance) (Direction) (Nearest Town)

Well / Borehole Data
Date drilling started: <u>9/17/16</u> Date drilling completed: <u>9/17/16</u> Hole depth: <u>108</u> Hole diameter: <u>26"</u>
Location of the source of any surface water used for drilling: _____
Method of dosing and volume of Chlorine used in drilling and development: _____
Logs run (circle all applicable): <u>No log run</u> Electric Gamma Ray Density Sonic Neutron Other: _____
Name of organization running log(s): _____
Purpose of borehole (circle one): <u>Water Well</u> Geotechnical/Geological Investigation Ground Source Heat Pump Seismic Survey Other (describe) _____
<i>If drilling is not related to water well construction, skip the remainder of this block</i>
Purpose of Well (circle all applicable): Home Industrial Public Supply <u>Irrigation</u> Fish Culture
Other (describe): _____
If a flowing well, method of flow regulation: Valve _____ Other (describe) _____
Static Water Level: <u>15</u> feet [above or <u>below</u>] land surface Date measured: _____ <small>(circle one)</small>
Method of measurement (circle one): <u>Steel tape</u> Electric tape Air line Other (describe): _____
Well depth: <u>108</u> Well grouted to a depth of: <u>10</u> feet Type of grout (circle one): <u>Neat Cement</u> Bentonite Mix
Casing length: <u>68</u> feet Casing diameter: <u>16</u> inches Type of casing: <u>PVC</u>
Screen length: <u>40</u> feet Screen diameter: <u>16</u> inches Type of screen: <u>PVC</u>
Screen slot size: <u>.032</u> inches Setting depth: From <u>68</u> feet to <u>108</u> feet
Type of completion (circle all applicable): <u>Gravel packed</u> Underreamed Open hole Natural Development
Other (describe): _____
Top of tap pipe or reduction in casing: _____ feet
<i>If telescoped or more than one screen, describe on next page</i>

RECEIVED

OCT 17 2016

Form: OLWR-SWR-1A (4/13)


BY OLWR

County: Waltham
 Permit #: MS-GW-49186

For Office Use Only:
 Well #: B144

The sketch below only required for water wells
If well telescopes, show depths on sketch.

Description of formations encountered must be provided for all wells
and boreholes, unless specifically exempted by regulations

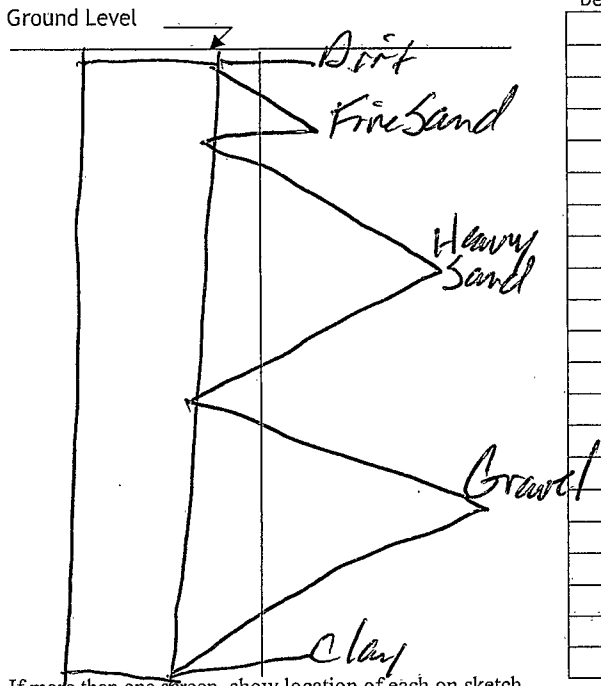

Description of Formations Encountered	From (depth)	To (depth)
Dirt	Ground level	10
Fine Sand	10	20
Heavy Sand	20	65
Gravel	65	107
Clay	107	108

If more than one screen, show location of each on sketch

- Sketch the property layout and include the following:
- 1) the well location
 - 2) any permanent structures on the property that may aid in locating the well
 - 3) any roads, power lines, or other items that may aid in locating the property and the well
 - 4) north arrow


RECEIVED
OCT 17 2016
BY OLWR

Landowner Name: _____

I HEREBY CERTIFY that the well/borehole was drilled, constructed, and completed in accordance with all applicable requirements of the Mississippi Department of Environmental Quality and the Mississippi Department of Health regulations, if applicable, and state laws.

Tommy Research GNR-3408 9-17-16 [Signature]
 Print Name of Responsible Licensee and License No. Date Signature of Licensee

B144

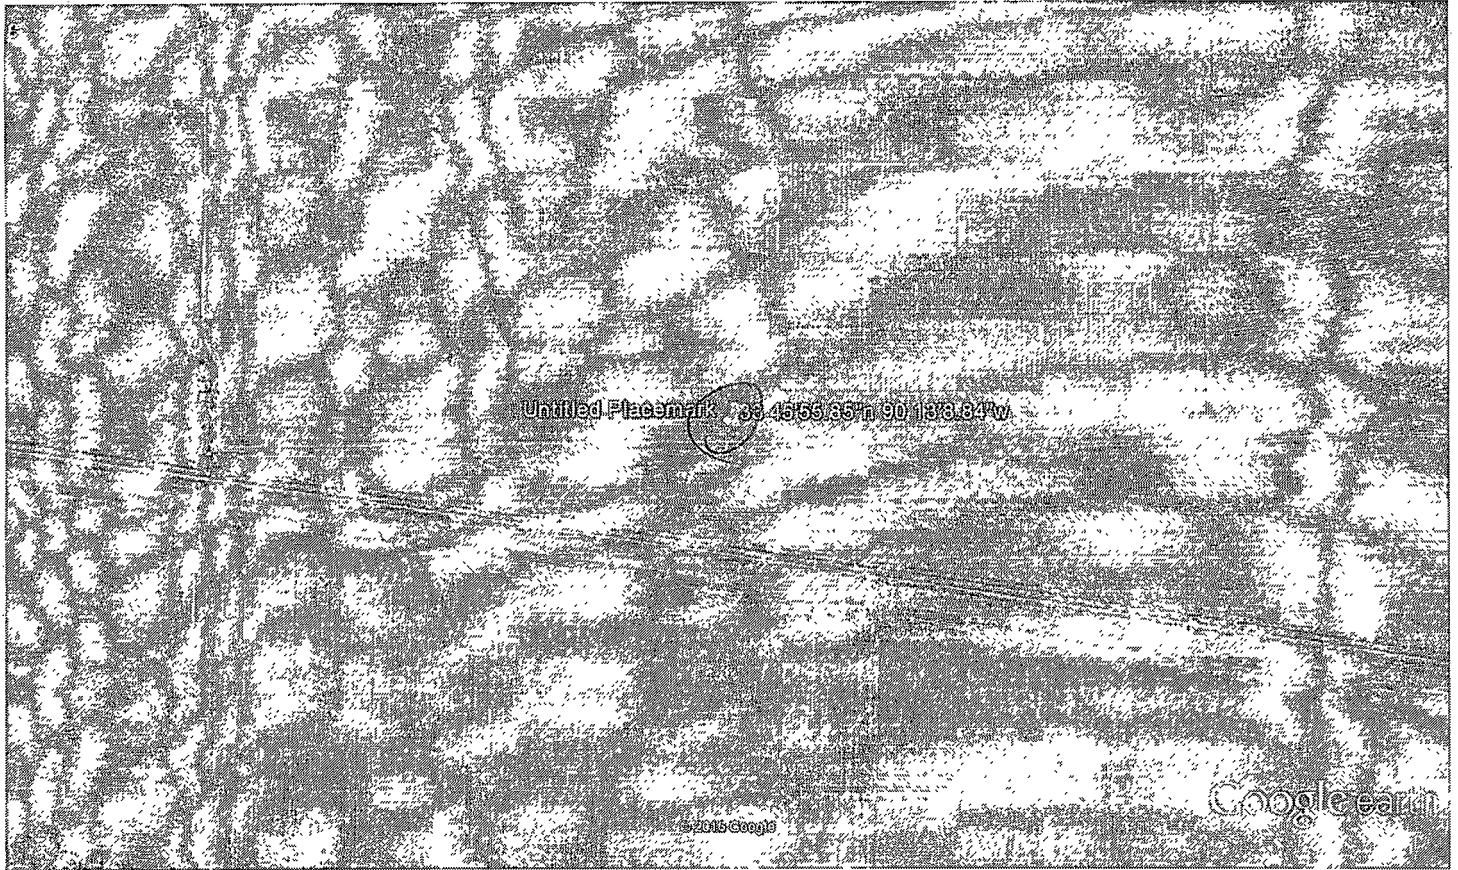

Google earth



RECEIVED
OCT 17 2016
BY OLWR

STATE OF MISSISSIPPI
Department of Environmental Quality
Office of Land and Water Resources
P. O. Box 2309
Jackson, Mississippi 39225

B144

PERMIT

TO DIVERT OR WITHDRAW FOR BENEFICIAL USE THE PUBLIC WATERS

This permit is issued to the landowner named below in accordance with the provisions of the Mississippi Water Laws, Mississippi Code Sections 51-3-1, et seq. (1972, as amended), and the regulations and standards as promulgated thereunder. Whether or not specifically named in this permit or in the applications for this permit, anyone using water from the diversion/withdrawal point described below shall do so in compliance with the provisions of this permit. Neither this permit, nor any authority conferred hereby, may be sold, conveyed, encumbered, assigned, or otherwise aliened, for any period of time or under any conditions whatsoever. This permit may not be modified, transferred or revoked without prior action by the Permit Board. Any attempts to modify, transfer or revoke this permit, or to take any other action on this permit, shall be invalid and unenforceable and may result in immediate revocation or suspension of this permit. The holder of this permit shall at all times be responsible for adherence to the terms and conditions of this permit. No agreement between the permit holder and any other party shall affect the obligations and liabilities of the permit holder. Water use under this permit is allowed only when the streamflow, lake level elevation, or static groundwater level (whichever, if any, is applicable) is above the established minimum, pursuant to Mississippi Code Section 51-3-7. Authorization is hereby granted to divert/withdraw water for the beneficial use designated herein, and for no other purpose, subject to the following terms, conditions, and limitations:

Permit Number: MS-GW-49186

Landowner Name: STAINBACK JR, RUFUS P

Landowner Address: PO BOX 85
MINTER CITY MS 38944

Source Of Water: MISSISSIPPI RIVER VALLEY ALLUVIAL AQUIFER

Beneficial Use: IRRIGATION

Diversion/Withdrawal Location: SW 1/4 of the SW 1/4 Section: 17 Township: 22N Range: 01E

County: LEFLORE

Quad: PHILIPP

Maximum Volume: 113 Acre-Foot/Year equivalent to .1009 Million Gallons/Day

Maximum Rate: 1000 Gallons/Minute

Applicant Name: BEULAH PLANTING COMPANY

Applicant Address: PO BOX 9
SCHLATER MS 38952

Date Permit Issued: 12/02/2015

Date Permit Expires: 12/02/2020

Date Permit Modified:

Date Permit Re-issued:

This permit shall be deemed null and void if construction has not begun within one (1) year of permit issue date

SPECIAL TERMS AND CONDITIONS: SEE ATTACHMENT 1, WHICH IS HEREBY DECLARED TO BE PART OF THIS PERMIT.

SPECIAL TERMS AND CONDITIONS 2:

RECEIVED

OCT 17 2016

BY OLWR

Gary C. Rikard, Executive Director
Mississippi Department of Environmental Quality

MEMORANDUM FOR THE RECORD

DATE: 10/15/54

RE: [Illegible]

[Illegible text block containing several lines of faded text]

[Illegible signature or name]

[Illegible text block]

[Illegible text block]

