

B-1001
7-28-62

WATER WELL DRILLERS LOG

Date: 7/28, 1962, Driller: Delta Well Supply Co. County Bolivar
(Name Leflore)

(1) Owner of Land: Billings & Stambaugh
(Name)
Wintter City
(Address)

(2) Location: 1/4, 1/4, Sec. 10 T22R1E,
6 miles N.E. of Wintter City
(distance) (direction) (Nearest Town)

(3) Topography: Flat
(Hilly) (Flat) (Level)

(4) Purpose of Well: Irrigation
(Domestic Irrigation
Municipal, Industrial, Other)

Description & Color of Materials Sand, Clay, Red Clay, Shell, etc.	Thick- ness Feet	Depth Feet
<u>sandy loam</u>	<u>14</u>	<u>14</u>
<u>fine sand</u>	<u>4</u>	<u>18</u>
<u>hard clay hard</u>	<u>20</u>	<u>38</u>
<u>sand stone</u>	<u>30</u>	<u>68</u>
<u>" red sand</u>	<u>35</u>	<u>103</u>

Information upon completion of well:

(1) Diameter 12 inches.

(2) Total Depth 103 feet.

(3) Water Level 14 feet below top of ground.

(4) Cased to _____, Size _____


(5) Screen: Size 12, Length 35

(6) Were any formations sealed against pollution?
_____ yes, no.

If YES depth of formation _____

Why _____

Drillers Remarks: _____

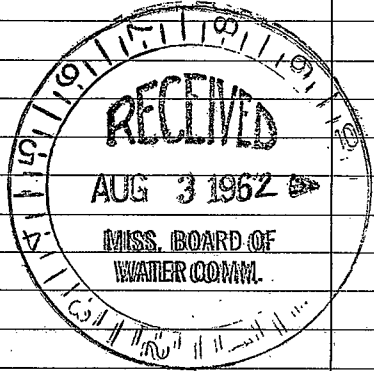

(Use Back Side)

Well No.

