

Lefflore  
B 7000

MISSISSIPPI DEPARTMENT OF NATURAL RESOURCES  
 Bureau of Land and Water Resources  
 Southport Mall  
 P.O. Box 10631  
 Jackson, Mississippi 39209  
**WATER WELL DRILLERS LOG**

4

4-25 1988 Lefflore  
 date well completed POST OFFICE BOX 1135  
GREENWOOD, MISS: 38930 county well located

LANDOWNER:  
M. C. McMillian  
 (mailing address)

description of formations encountered	from	to
Clay	0	25
sand	25	65
gravel	65	115
Clay	115	210
Clay & Rock	210	235
sand & rock st	235	290
Sand, Shale	290	320
gummy shale	320	500
hard shale	500	575
Shale & sand	575	660
Sand	660	690

WELL LOCATION:  
 sec. 15 T 22 N R. 1 E  
8 miles E of Winter Co  
 (distance) (direction) (nearest town)

WELL PURPOSE: Domestic  
 (home, irrigation, municipal, industrial)

- WELL COMPLETION DATA:
- (1) diameter (inches) 4" x 2"
  - (2) total depth (feet) 689
  - (3) static water level (feet) Flow below  
105' top of ground. above
  - (4) casing steel, 559'  
4" (material), (depth)  
2" if telescope see back.  
 (size)
  - (5) screen 25'  
 (length), (depth to top)  
2", steel  
 (size), (material)
  - (6) pump 1 14  
 (HP) (yield gpm)  
Elect.  
 (type power)
  - (7) electric log No  
 (yes or no)  
No  
 (organization running log)
  - (8) how well bottom plugged  
Back work done

DRILLERS REMARKS:  
Richard



DEPT. OF NATURAL RESOURCES  
 BUREAU OF LAND & WATER RESOURCES

MAY 6 - 1983

**RECEIVED**

If well telescopes please sketch and show depths.

GROUND LEVEL

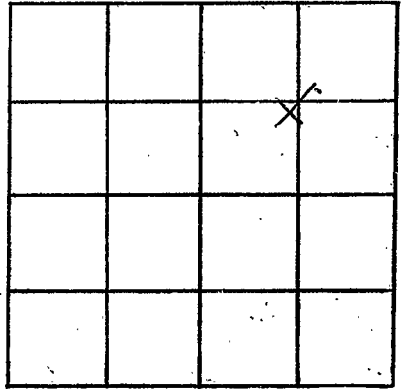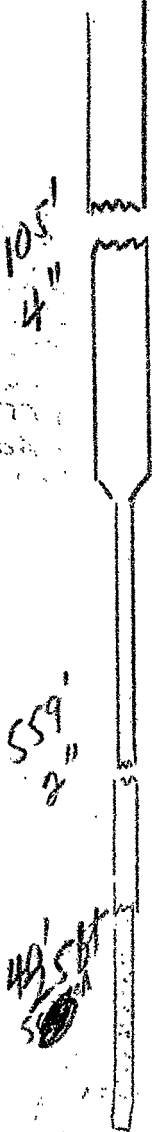

SECTION 15

Please indicate well location X.

ADDITIONAL INFORMATION

Multiple horizontal lines for additional information.

If more than one screen, show locations of each on sketch.