


LEFLORE MISSISSIPPI BOARD OF WATER COMMISSIONERS

4-18-66

WATER WELL DRILLERS LOG

Date: April 18, 1966, Driller: Butane Gas Co. of Greenwood, Leflore County
(Name)

	Description & Color of Materials <small>Sand, Clay, Red Clay, Shell, etc.</small>	Thick-ness Feet	Depth Feet
(1) Owner of Land: <u>Equen Plantation</u> <small>(Name)</small>	sandy	42	42
<u>Minter City, Miss.</u> <small>(Address)</small>	sand & pea gravel	57	99
(2) Location: <u>1/4</u> , <u>1/4</u> , Sec. <u> </u> T <u> </u> R <u> </u> , <u>4</u> miles <u>SW</u> of <u>Glendora</u> <small>(distance) (direction) (Nearest Town)</small>	rock	2	101
(3) Topography: <u>flat</u> <small>(Hilly) (Flat) (Level)</small>	sand	6	107
(4) Purpose of Well: <u>domestic</u> <small>(Domestic Irrigation Municipal, Industrial, Other)</small>	rock	2	109
Information upon completion of well: 4" x 2 1/2" x 2"	sand	8	117
(1) Diameter _____ inches.	rock	2	119
(2) Total Depth <u>1192</u> feet.	sand	17	136
(3) Water Level <u>flowing</u> feet below top of ground.	rock	3	139
(4) Cased to <u>1134</u> , Size <u>4 x 2 1/2</u>	clay	52	191
(5) Screen: Size <u>.010</u> , Length <u>30</u>	sandy shale	98	289
(6) Were any formations sealed against pollution? _____ yes, <input checked="" type="checkbox"/> no.	gummy shale shale	96	385
If YES depth of formation _____	rock	1	386
Why _____	sandy shale	20	406
Drillers Remarks: _____	hard shale & rock st.	15	421
Yield in GPM: <u>15</u>	hard shale	38	459
Type Power: <u>electric</u>	rock	1	450
Crops irrigated: <u>none</u>	hard shale rock st.	32	682
	gummy shale	13	695
	Hard shale sand st.	216	911
	gummy shale	8	919
	shale, sand st.	161	1080
	gummy shale	7	1087
	H. P. sand	83	1170
	sahle	22	1192

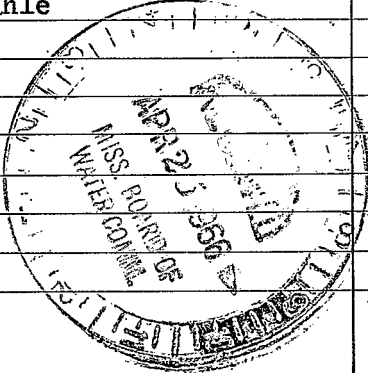

Well No.

(Use Back Side)

Mail this copy to Board of Water Commissioners 429 Miss. St. Jackson, Miss.

