

MISSISSIPPI DEPARTMENT OF NATURAL RESOURCES

Bureau of Land and Water Resources

Southport Mall

P.O. Box 10631

Jackson, Mississippi 39209


WATER WELL DRILLERS LOG

Leflore
B 2002
4-9-81

4-9-81 19
 date well completed


BUTANE GAS CO. OF GREENWOOD
 firm name

Leflore
 county well located

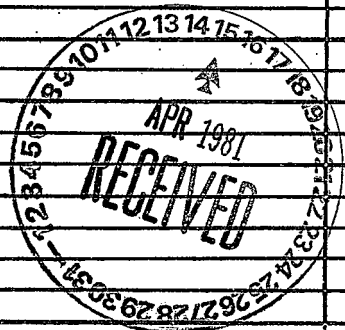LANDOWNER:	description of formations encountered	from	to
<u>M. L. McMillan</u>			
<u>Minster City</u> (mailing address)	<u>Clay</u> <u>sand</u>	<u>0</u>	<u>50</u>
<p>WELL LOCATION:</p> <p>sec. <u>10</u> T <u>2N</u> R <u>1E</u> & <u>6</u> miles <u>E</u> of <u>Minster City</u> (distance) (direction) (nearest town)</p>			
<p>WELL PURPOSE: <u>FARM</u> (home, irrigation, municipal, industrial)</p>			
<p>WELL COMPLETION DATA:</p> <p>(1) diameter (inches) <u>4"</u></p> <p>(2) total depth (feet) <u>105</u></p> <p>(3) static water level (feet) <u>40</u> below top of ground.</p> <p>(4) casing <u>PVC</u> <u>85'</u> (material) (depth) <u>4"</u> if telescope see back. (size)</p> <p>(5) screen <u>20'</u> <u>85'</u> (length) (depth to top) <u>4"</u> <u>PVC</u> (size) (material)</p> <p>(6) pump <u>3/4</u> <u>15</u> (HP) (yield gpm) <u>Elec</u> (type power)</p> <p>(7) electric log <u>No</u> (yes or no)</p> <p>(organization running log)</p> <p>(8) how well bottom plugged <u>Back mess see above</u></p>			
<p>DRILLERS REMARKS:</p>			

If well telescopes please sketch and show depths.

GROUND LEVEL

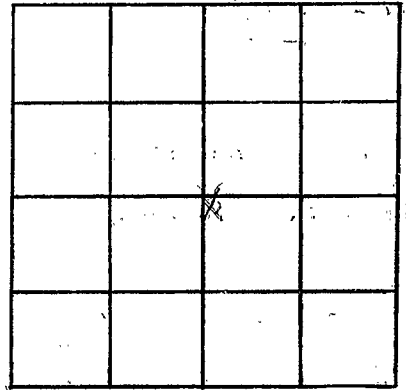

SECTION _____

Please indicate well location X.

ADDITIONAL INFORMATION

If more than one screen,
show locations of each on sketch.