

Lallara  
 B<sup>o</sup> 2003  
 2-12-76

MISSISSIPPI  
 BOARD OF WATER COMMISSIONERS  
 416 North State Street  
 Jackson, Mississippi 39201

WATER WELL DRILLERS LOG

BUTANE GAS CO. OF GREENWOOD LeFlore

2-12-76 19 date well completed firm name county well located

LANDOWNER:  
 D.E. Reynolds  
 LeFlore  
 (mailing address)

WELL LOCATION:  
 sec. 2 T 22 N R 1 E  
 & 3/2 miles NE of M. city  
 (distance) (direction) (nearest town)

WELL PURPOSE: Home  
 (home, irrigation, municipal, industrial)

WELL COMPLETION DATA:  
 (1) diameter (inches) 4x2  
 (2) total depth (feet) 975  
 (3) static water level (feet) 5 below above top of ground.  
 (4) casing Steel 955 (material) (depth)  
 4x2 (size) if telescope see back.  
 (5) screen 20 955 (length) (depth to top)  
 2" stainless (size) (material)  
 (6) pump 1 15 (HP) (yield gpm)  
 Elec. (type power)  
 (7) electric log No (yes or no)  
 (organization running log)  
 (8) how well bottom plugged Back Pressure Valve

description of formations encountered	from	to
Clay	0	10
SAND	10	60
SAND & GRAVEL	60	115
Clay	115	210
SAND	210	280
Clay	280	340
SAND	340	400
Clay	400	646
Brown Sand	646	675
Clay	675	715
SAND	715	775
SAND & CLAY	775	910
SAND	910	975

REGISTERED  
 FEB 18 1976

MISS. BD. OF WATER COMMISSIONERS

DRILLERS REMARKS:


If well telescopes please sketch and show depths.

GROUND LEVEL

105'-4" CASING →

85'-2" CASING →

20'-2" SCREEN →

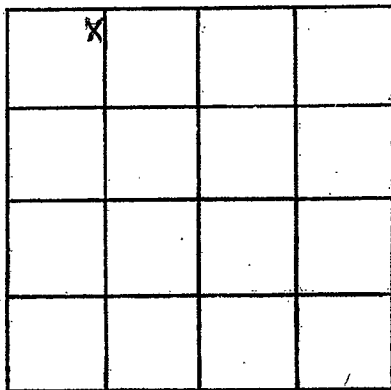

SECTION 2

Please indicate well location X.

ADDITIONAL INFORMATION

If more than one screen, show locations of each on sketch.