

# MISSISSIPPI DEPARTMENT OF NATURAL RESOURCES

Bureau of Land and Water Resources

COUNTY WELL LOCATED <i>Leflore</i>	
WELL NUMBER <i>6</i>	CODED
<i>B97004</i>	
DATE WELL COMPLETED <i>1-26-89</i>	

1080
PERMIT NUMBER
NAME OF DRILLING FIRM <i>Dyer Well</i>

P.O. Box 10631  
Jackson, Mississippi 39209  
WATER WELL DRILLERS LOG

NAME & MAILING ADDRESS OF LANDOWNER <i>F &amp; G Farms</i>			
<i>Box 552</i>			
<i>Webb, Ms. 38966</i>			
WELL LOCATION:	SEC	TOWNSHIP	RANGE
	<i>8</i>	<i>22</i> <sup>N</sup> S	<i>1</i> <sup>E</sup> W
DISTANCE	DIRECTION		NEAREST TOWN
_____ Miles	_____ of _____		
OTHER LANDMARK			
WELL PURPOSE: Home, <u>Irrigation</u> , Municipal, Industrial, Fish Pond, etc.			

PUMP DATA		
PUMP TYPE (Circle One): Submersible, <u>Turbine</u> , Jet, Flowing Well, Other (Describe) _____		
POWER TYPE (Circle One): Electric, Tractor, <u>Diesel</u> , Gasoline, Butane, Other (Describe) _____		
Pump Capacity (GPM) <i>1450</i>	No. of Stages <i>4</i>	Setting Depth <i>50</i> FT.
PUMP TEST		
Well yielded _____ GPM with a drawdown of _____ ft. after _____ hours of pumping		

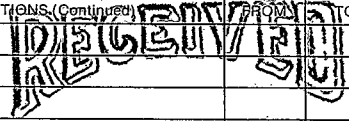
WELL DATA		
Well Depth <i>102'</i>	Casing Diameter (In.) <i>12"</i>	Casing Length (Ft.) <i>62'</i>
Type of Casing <i>Iron</i>	Hole Depth <i>102</i>	Depth to Static Water Level
TYPE OF COMPLETION: (Circle One or More): <u>Gravel Packed</u> , Underreamed, Telescoped, Natural Development, Open Hole, Other		
Top of Lap Pipe or Reduction in Casing		
FEET IF TELESCOPED OR MORE THAN ONE SCREEN: USE BACK PAGE		

LOG DATA	
TYPE OF LOG RUN (Circle One): Electric, Gamma Ray, Density, Sonic, Neutron, Other (Describe) _____	
<u>No Log Run</u>	
Name of Organization Running Log <i>None</i>	

SCREEN DATA		
Diameter - Inches <i>12"</i>	Length - Feet <i>40'</i>	Slot Size - Inches <i>.030</i>
Screen Type <i>Johnson</i>	Depth to Bottom - Feet	

GEOLOGIC DATA (Office Use Only)			
Surface Elev.	Geologic Unit	Unit Thickness	Depth to Top
Subs. SWL	Date	Analysis	Aquifer Test

Driller's Remarks

DESCRIPTION OF FORMATIONS ENCOUNTERED	FROM	TO	FORMATIONS (Continued) FROM TO
<i>Clay</i>	<i>0</i>	<i>35</i>	<div style="text-align: center;">   <b>FEB 6 1989</b>                      Department of Natural Resources                      Bureau of Land &amp; Water Resources                 </div>
<i>Fine Sand</i>	<i>35</i>	<i>64</i>	
<i>Fine Sand &amp; Gravel</i>	<i>64</i>	<i>80</i>	
<i>M Sand &amp; Gravel</i>	<i>80</i>	<i>102</i>	

IF MORE SPACE IS NEEDED, USE BACK

If well telescopes please sketch and show depths.

GROUND LEVEL


SECTION \_\_\_\_\_

Please indicate well location X.

ADDITIONAL INFORMATION

If more than one screen,  
show location of each on sketch.