

MISSISSIPPI DEPARTMENT OF NATURAL RESOURCES

Bureau of Land and Water Resources

Southport Mall

P.O. Box 10631

Jackson, Mississippi 39209

WATER WELL DRILLERS LOG

TEP  
11748-ESD-4-9-89  
LEFORE BROS

1080

3-17 1989 Dyer Well LeFlore  
date well completed firm name county well located


LANDOWNER: F + G Farms  
Box 552  
Webb, Ms. 38966  
(mailing address)

description of formations encountered	from	to
CLAY	0	21
Fine Sand	21	48
Fine Sand + Gravel	48	60
M. Sand + Gravel	60	73
Fine Sand + Gravel	73	76
Fine Sand	76	90
Sand + Gravel	90	104
Fine Sand + Gravel	104	118

WELL LOCATION:  
sec. 8 T 22 N S R 1 E W  
miles of (distance) (direction) (nearest town)

WELL PURPOSE: IRRIGATION  
(home, irrigation, municipal, industrial)

- WELL COMPLETION DATA:
- (1) diameter (inches) 12"
  - (2) total depth (feet) 118"
  - (3) static water level (feet) below top of ground.
  - (4) casing steel 158' (material), (depth)
  - 12" (size) if telescope see back.
  - (5) screen 40' 158' (length), (depth to top)
  - 12" (size), (material)
  - (6) pump (HP) (yield gpm)
  - Engine (type power)
  - (7) electric log No (yes or no)
  - None (organization running log)
  - (8) how well bottom plugged Plate

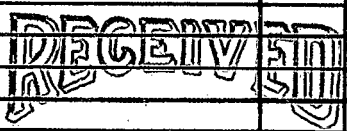


MAR 21 1989

Department of Natural Resources  
Bureau of Land & Water Resources

DRILLERS REMARKS:

If well telescopes please sketch and show depths.

GROUND LEVEL

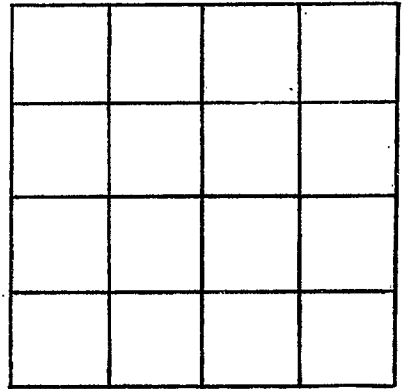

SECTION \_\_\_\_\_

Please indicate well location X.

ADDITIONAL INFORMATION

If more than one screen,  
show locations of each on sketch.