

MISSISSIPPI DEPARTMENT OF NATURAL RESOURCES

Bureau of Land and Water Resources

P.O. Box 10631

Jackson, Mississippi 39209

WATER WELL DRILLERS LOG

COUNTY WELL LOCATED
Letflore

WELL NUMBER B2007 CODED

5-2-90

DATE WELL COMPLETED

PERMIT NUMBER

NAME OF DRILLING FIRM
Butane Gas Co.

NAME & MAILING ADDRESS OF LANDOWNER
J.W. FENNELL

Glendora, Miss.

WELL LOCATION: SEC 3 TOWNSHIP 22 RANGE 1
N W

DISTANCE 2 Miles S of Glendora

OTHER LANDMARK

WELL PURPOSE: Home, Irrigation, Municipal, Industrial, Fish-Pond, etc.
Irrigation

PUMP DATA

PUMP TYPE (Circle One):
~~Submersible~~ Turbine, Jet, Flowing Well,
Other (Describe)

POWER TYPE (Circle One):
Electric Tractor, Diesel, Gasoline, Butane,
Other (Describe) H/P 2

Pump Capacity (GPM) 50 No. of Stages 8 Setting Depth 84 FT.

PUMP TEST

Well yielded _____ GPM with
a drawdown of _____ ft.
after _____ hours of pumping

WELL DATA

Well Depth <u>105</u>	Casing Diameter (In.) <u>4</u>	Casing Length (Ft.) <u>85</u>
Type of Casing <u>PVC</u>	Hole Depth <u>105</u>	Depth to Static Water Level <u>22</u>

TYPE OF COMPLETION: (Circle One or More):
Natural Development, Gravel Packed, Underreamed, Telescoped,
Open Hole, Other

Top of Lap Pipe or Reduction in Casing

FEET IF TELESCOPED OR MORE THAN ONE SCREEN: USE BACK PAGE

LOG DATA

TYPE OF LOG RUN (Circle One): No Log Run,
Electric, Gamma Ray, Density, Sonic, Neutron,
Other (Describe)

Name of Organization Running Log

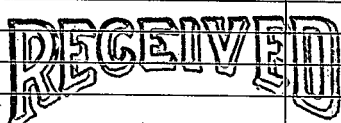
SCREEN DATA

Diameter - Inches <u>4</u>	Length - Feet <u>20</u>	Slot Size - Inches <u>1010</u>
Screen Type <u>PVC</u>	Depth to Bottom - Feet <u>105</u>	

GEOLOGIC DATA (Office Use Only)

Surface Elev.	Geologic Unit	Unit Thickness	Depth to Top
Subs. SWL	Date	Analysis	Aquifer Test

Driller's Remarks

DESCRIPTION OF FORMATIONS ENCOUNTERED	FROM	TO	FORMATIONS (Continued)	FROM	TO
<u>Top Sand</u>	<u>0</u>	<u>10</u>	 JUN 04 1990 Department of Natural Resources Bureau of Land & Water Resources		
<u>Clay</u>	<u>10</u>	<u>25</u>			
<u>Sand</u>	<u>25</u>	<u>65</u>			
<u>Gravel</u>	<u>65</u>	<u>105</u>			

IF MORE SPACE IS NEEDED, USE BACK

If well telescopes please sketch and show depths.

GROUND LEVEL

		X	

SECTION 3

Please indicate well location X.

ADDITIONAL INFORMATION

If more than one screen,
show location of each on sketch.