

Leflore
C 21
2-23-70

MISSISSIPPI
 BOARD OF WATER COMMISSIONERS
 416 North State Street
 Jackson, Mississippi 39201

WATER WELL DRILLERS LOG
 DYER WELL & IRRIGATION

CODED

Leflore

2-23-70 19
 date well completed

firm name

county well located

LANDOWNER:
Pee Dee Planting Co.
Doddsville, Miss.
 (mailing address)

description of formations encountered	from to	
	from	to
<u>Clay</u>	<u>0</u>	<u>23</u>
<u>Fine Sand</u>	<u>23</u>	<u>33</u>
<u>Sand & Pea Gravel</u>	<u>33</u>	<u>105</u>

WELL LOCATION:
 sec. 18 T. 21 N. R. 2 E. W. W
7 miles NE of Schlater
 (distance) (direction) (nearest town)

WELL PURPOSE: IRR.
 (home, irrigation, municipal, industrial)

- WELL COMPLETION DATA:
- (1) diameter (inches) 16"
 - (2) total depth (feet) 105
 - (3) static water level (feet) 17 below above top of ground.
 - (4) casing Steel, 65,
 (material) (depth)
16" if telescope see back.
 (size)
 - (5) screen 40', 65
 (length) (depth to top)
16", Steel
 (size) (material)
 - (6) pump 60, 3000
 (HP) (yield gpm)
Elec.
 (type power)
 - (7) electric log No
 (yes or no)

CODED

(organization running log)

(8) how well bottom plugged Plate


MAR 17 1970

DRILLERS REMARKS:

MISS. BD. OF
 WATER COMM.

If well telescopes please sketch and show depths.

GROUND LEVEL

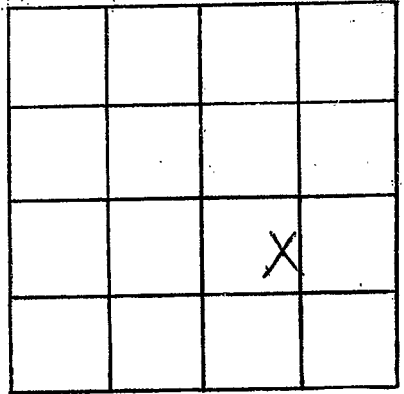

SECTION 18

Please indicate well location X.

ADDITIONAL INFORMATION

If more than one screen,
show locations of each on sketch.