

LEFLORE  
C 22  
2-71

MISSISSIPPI  
BOARD OF WATER COMMISSIONERS  
416 North State Street  
Jackson, Mississippi 39201

**CODED**

WATER WELL DRILLERS LOG

DYER WELL & IRRIGATION SERVICE

LEFLORE

date well completed

firm name

county well located

LANDOWNER:

LARE LINDSEY

description of formations encountered

from

to

Ruledine, Miss.  
(mailing address)

CLAY	0	18
FINE SAND	18	34
SAND MED	34	44
SAND + PEA ROCK	44	57
SAND, PEA ROCK AND LARGE GRAVEL	57	113

WELL LOCATION:

sec. 9 T 21 N R 2 E  
3 miles N.W. of SW LATER (nearest town)

WELL PURPOSE: IRRIGATION  
(home, irrigation, municipal, industrial)

WELL COMPLETION DATA:

- (1) diameter (inches) 16"
- (2) total depth (feet) 113'
- (3) static water level (feet) 18' below above top of ground.
- (4) casing Blue IR, 73' (material), (depth)  
16" (size) if telescope see back.
- (5) screen 40' 73' (length), (depth to top)  
16" Blue IR. (size), (material)
- (6) pump 60 3000 (HP), (yield gpm)  
ECC. (type power)
- (7) electric log No (yes or no)

**CODED**

(organization running log)

(8) how well bottom plugged PLATE


MAR 22 1971

DRILLERS REMARKS:

MISS. Bd. OF WATER COMM.

If well telescopes please sketch and show depths.

GROUND LEVEL

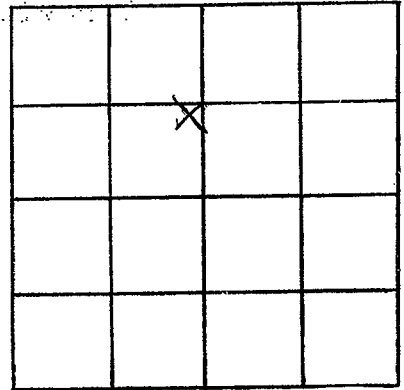

SECTION 9

Please indicate well location X.

ADDITIONAL INFORMATION

If more than one screen,  
show locations of each on sketch.