

LEFLORE  
C 23  
6-26-71

MISSISSIPPI  
 BOARD OF WATER COMMISSIONERS  
 416 North State Street  
 Jackson, Mississippi 39201

**CODED**

WATER WELL DRILLERS LOG

6/26 / date well completed    1971 - Pella Well & Supply Co. Leflore / firm name    Leflore / county well located

LANDOWNER:  
H. M. Arant  
Raleville - Miss.  
 (mailing address)

description of formations encountered	from	to
<u>Top Soil &amp; Subsoil</u>	<u>0</u>	<u>29</u>
<u>Loam, sand</u>	<u>29</u>	<u>48</u>
<u>Sand &amp; gravel</u>	<u>48</u>	<u>100</u>
<u>Med. sand</u>	<u>100</u>	<u>110</u>
<u>Sand stone</u>	<u>110</u>	<u>?</u>

WELL LOCATION:  
 sec. 9 T. 21 N. R. 2 W.  
7 miles So. west of Water City  
 (distance) (direction) (nearest town)

WELL PURPOSE: Domestic  
 (home, irrigation, municipal, industrial)

- WELL COMPLETION DATA:
- (1) diameter (inches) 16
  - (2) total depth (feet) 110
  - (3) static water level (feet) 222 below above top of ground.
  - (4) casing Steel (material) (depth)
  - \_\_\_\_\_ if telescope see back. (size)
  - (5) screen 110 (length) (depth to top)
  - 16 (size) Steel (material)
  - (6) pump 30 (HP) 9000 (yield gpm)
  - I.P. Sigs. (type power)
  - (7) electric log No (yes or no)
  - \_\_\_\_\_ (organization running log)
  - (8) how well bottom plugged Concrete

**CODED**


JUN 28 1971

MISS. BD. OF  
 WATER COM.

DRILLERS REMARKS: \_\_\_\_\_

If well telescopes please sketch and show depths.

GROUND LEVEL

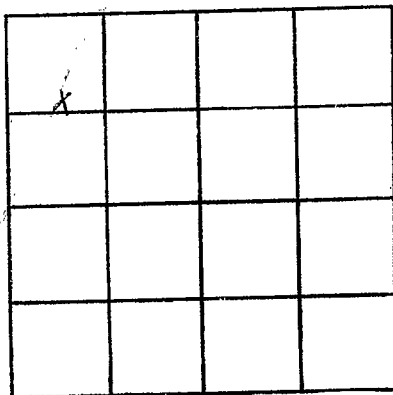

SECTION 9

Please indicate well location X.

ADDITIONAL INFORMATION

If more than one screen,  
show locations of each on sketch.