

LEFLORE
 C 25
 3-26-69

MISSISSIPPI
 BOARD OF WATER COMMISSIONERS
 416 North State Street
 Jackson, Mississippi 39201

WATER WELL DRILLERS LOG

CODING

3-26 1969 OVER WELLS IRR. SERV LE FLORE
 date well completed firm name county well located

LANDOWNER: HUNTER CHITTON

GREENWOOD
MISS.
 (mailing address)

WELL LOCATION:
 sec 17 T 21 N R 2 X
4 1/2 miles N.W. of SCHULTER
 (distance) (direction) (nearest town)

WELL PURPOSE: IRR.
 (home, irrigation, municipal, industrial)

WELL COMPLETION DATA:

- (1) diameter (inches) 16"
- (2) total depth (feet) 95'
- (3) static water level (feet) 19' below above top of ground.
- (4) casing BLK IR, 55'
 (material) (depth)
16" if telescope see back.
 (size)
- (5) screen 40', 55'
 (length) (depth to top)
16", BLUE INGOT
 (size) (material)
- (6) pump 60, 2700
 (HP) (yield gpm)
ELFC.
 (type power)
- (7) electric log NO
 (yes or no)

(organization running log)

(8) how well bottom plugged PLATE

DRILLERS REMARKS:

description of formations encountered	from	to
CLAY	0	24
FINE SAND	24	33
MED SAND	33	43
COARSE SAND	43	53
MED SAND	53	58
COARSE SAND & GRAVEL	58	83
GRAVEL	83	93
BIG ROCK	93	95

CODING


CODING

APR 29 1969

MISS. BD. OF
 WATER COMM.

If well telescopes please sketch and show depths.

GROUND LEVEL

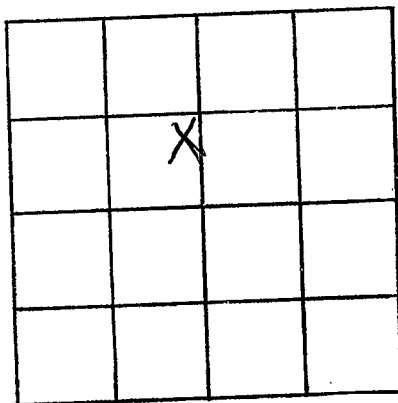

SECTION 17

Please indicate well location X.

ADDITIONAL INFORMATION

If more than one screen,
show locations of each on sketch.