

Leflore

C-28

WATER WELL DRILLERS LOG

CODED

11-18-60

Date: 11-18, 1960, Driller: FANTANE HAS CONCRETE County: LEFLORE

1034

(Name)

(1) Owner of Land: SCHLATER GIN CO (Name)

SCHLATER, MISS (Address)

(2) Location: 1/4, 1/4, Sec. 36 T21R2W

0 miles (distance), of SCHLATER (Nearest Town)

(3) Topography: FLAT (Hilly) (Flat) (Level)

(4) Purpose of Well: FIRE PROTECTION (Domestic Irrigation Municipal, Industrial, Other)

Information upon completion of well:

(1) Diameter: 4 inches.

(2) Total Depth: 83 feet.

(3) Water Level: 17 feet below top of ground.

(4) Cased to: 63', Size: 4"

(5) Screen: Size: 4", Length: 20'

(6) Were any formations sealed against pollution?

yes, X no.


If YES depth of formation

Why

Drillers Remarks:

Description & Color of Materials Sand, Clay, Red Clay, Shell, etc.	Thick- ness Feet	Depth Feet
CLAY	18	18
SILT	15	33
COARSE SAND	8	41
SAND PEAR ROCK	16	57
PEAR ROCK - ROCK	26	83

CODED

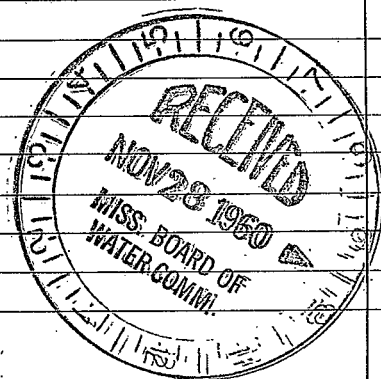

(Use Back Side)

Well No.

1950

1950