

Before MISSISSIPPI BOARD OF WATER COMMISSIONERS

C-29

1-9-64

WATER WELL DRILLERS LOG

CODED

Date: JAN 9, 1964, Drillers: DELTA DRILLING Co. County LEFLORE
(Name)


(1) Owner of Land:	Description & Color of Materials Sand, Clay, Red Clay, Shell, etc.	Thick- ness Feet	Depth Feet
<u>B.H. HERRING & E.S. BARRENTINE</u> (Name)	<u>GUMBO</u>	<u>50</u>	<u>50</u>
<u>SCHLATER, MISS-</u> (Address)	<u>SAND</u>	<u>17</u>	<u>67</u>
(2) Location: <u>1/4</u> , <u>1/4</u> , Sec. <u>10</u> <u>T20R24</u>	<u>GRAVEL</u>	<u>77</u>	<u>144</u>
<u>11</u> miles _____ of _____ (distance) (direction) (Nearest Town)	<u>SAND</u>	<u>40</u>	<u>184</u>
(3) Topography: _____ (Hilly) (Flat) (Level)	<u>GUMBO</u>	<u>33</u>	<u>217</u>
(4) Purpose of Well: _____ (Domestic Irrigation, Municipal, Industrial, Other)	<u>SAND</u>	<u>40</u>	<u>257</u>
	<u>GUMBO</u>	<u>25</u>	<u>282</u>
	<u>SAND</u>	<u>14</u>	<u>296</u>
	<u>GUMBO</u>	<u>74</u>	<u>370</u>
	<u>SAND</u>	<u>120</u>	<u>490</u>
	<u>GUMBO W/12" ROCK</u>	<u>66</u>	<u>556</u>
	<u>GREEN SAND W/ROCKS</u>	<u>72</u>	<u>628</u>
	<u>SHALE</u>	<u>62</u>	<u>690</u>
	<u>GREEN SAND W/ROCK</u>	<u>38</u>	<u>728</u>
	<u>SHALE W/ROCK</u>	<u>42</u>	<u>770</u>
	<u>GREEN SAND</u>	<u>78</u>	<u>848</u>
	<u>SHALE</u>	<u>52</u>	<u>900</u>
	<u>GUMBO W/ROCK</u>	<u>42</u>	<u>948</u>
	<u>SHALE</u>	<u>57</u>	<u>970</u>
	<u>SAND</u>	<u>36</u>	<u>1006</u>
	<u>GUMBO</u>	<u>32</u>	<u>1038</u>
	<u>SAND</u>	<u>10</u>	<u>1048</u>
	<u>GUMBO</u>	<u>10</u>	<u>1058</u>
	<u>SAND</u>	<u>52</u>	<u>1110</u>

Information upon completion of well:

- (1) Diameter 3 inches.
- (2) Total Depth 1110 feet.
- (3) Water Level FLOWS feet below top of ground.
- (4) Cased to 1090, Size _____.
- (5) Screen: Size 2", Length 20'.
- (6) Were any formations sealed against pollution?
_____ yes, _____ no.

If YES depth of formation _____
Why _____

Drillers Remarks: 22'-LAP OF 2"
IN 3" PIPE- FLOWS 60
G.P.M.

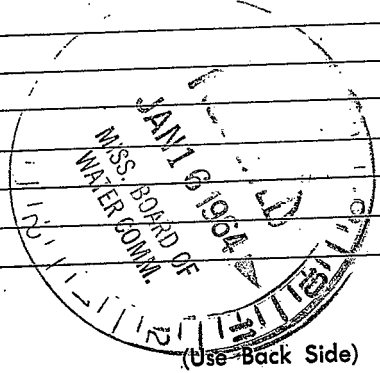

Well No.

100-100000-100000

100-100000-100000



Mail this copy to