

Leflore

MISSISSIPPI BOARD OF WATER COMMISSIONERS

AC-30

2-66

WATER WELL DRILLERS LOG

CODED

Date: 2/17, 1966, Driller: Butane Gas Co. of Greenwood County Leflore

(Name)

(1) Owner of Land: Hunter Chittom
 (Name)
Schlater, Miss.
 (Address) 7, 8, 10, 21, 20, 21, 29
 (2) Location: 1/4, 1/4, Sec. T R
7 miles north of Schlater
 (distance) (direction) (Nearest Town)
 (3) Topography: flat
 (Hilly) (Flat) (Level)
 (4) Purpose of Well: irrigation
 (Domestic Irrigation
 Municipal, Industrial, Other)

Description & Color of Materials Sand, Clay, Red Clay, Shell, etc.	Thick- ness Feet	Depth Feet
Top soil	13	13
Clay	10	23
"	10	33
Coarse sand	10	43
" "	10	53
" "	10	63
Sand & gravel	10	73
" "	10	83
Gravel	10	93
"	10	103

Information upon completion of well:


(1) Diameter 16 inches.
 (2) Total Depth 103 feet.
 (3) Water Level 15' 6" feet below top of ground.
 (4) Cased to 63, Size 16
 (5) Screen: Size 16, Length 40'
 (6) Were any formations sealed against pollution?
yes, X no.

If YES depth of formation _____

Why _____

Drillers Remarks: _____

CODED

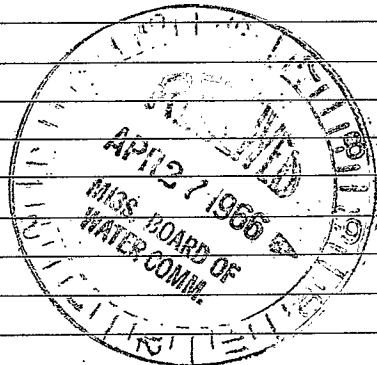

(Use Back Side)

Well No.

100