

MISSISSIPPI BOARD OF WATER COMMISSIONERS

Leflore  
C 31  
2-66

WATER WELL DRILLERS LOG

Date: 2/22, 1966, Driller: Butane Gas Co. of Greenwood County Leflore

(Name)

(1) Owner of Land: Harold Coleman  
(Name)  
Schlater, Miss.  
(Address)

(2) Location: 1/4, 1/4, Sec. T R  
7 miles NW of Schlater  
(distance) (direction) (Nearest Town)

(3) Topography: flat  
(Hilly) (Flat) (Level)

(4) Purpose of Well: irrigation  
Domestic Irrigation, Manufacturing, Industrial, Other

**CODED**

Information upon completion of well:

- (1) Diameter 16 inches.
- (2) Total Depth 103 feet.
- (3) Water Level 17 feet below top of ground.
- (4) Cased to 63, Size 16
- (5) Screen: Size 16, Length 40'
- (6) Were any formations sealed against pollution?  
yes,  no.


If YES depth of formation

Why

Drillers Remarks:

Description & Color of Materials Sand, Clay, Red Clay, Shell, etc.	Thick- ness Feet	Depth Feet
Top soil	13	13
Clay	10	23
Fine sand	10	33
" "	10	43
" "	10	53
Sand & gravel	10	63
" "	10	73
" "	10	83
" "	10	93
Large rock	10	103

**CODED**

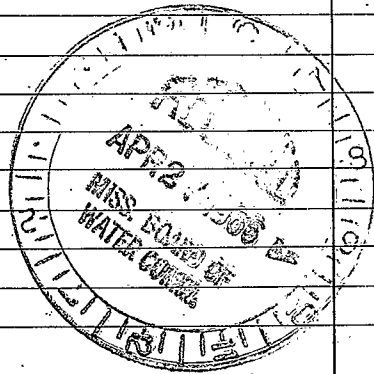

(Use Back Side)

Well No.

