

MISSISSIPPI BOARD OF WATER COMMISSIONERS

Leflore  
C-31  
2-66

WATER WELL DRILLERS LOG

**CODED**

Date: 2/19, 19 66, Driller: Butane Gas Co. of Greenwood County Leflore

(Name)

(1) Owner of Land: Harold Coleman  
(Name)  
Schlater, Miss.  
(Address) 16, 19, 21 21 2W  
30, 31, 32, 33

(2) Location: 1/4, 1/4, Sec. T R  
6 miles NW, of Schlater  
(distance) (direction) (Nearest Town)

(3) Topography: flat  
(Hilly) (Flat) (Level)

(4) Purpose of Well: irrigation  
(Domestic Irrigation  
Municipal, Industrial, Other)

Code 6

Description & Color of Materials Sand, Clay, Red Clay, Shell, etc.	Thick- ness Feet	Depth Feet
Top soil	13	13
Brown Clay	10	23
Fine Sand	10	33
Coarse sand	10	43
Sand & gravel	10	53
" "	10	63
Large gravel	10	73
" "	10	83
" "	10	93
Large rock	10	103

Information upon completion of well:

(1) Diameter 16 inches.

(2) Total Depth 103 feet.

(3) Water Level 16 feet below top of ground.

(4) Cased to 63, Size 16


(5) Screen: Size 16, Length 40'

(6) Were any formations sealed against pollution?  
yes, X no.

If YES depth of formation \_\_\_\_\_  
Why \_\_\_\_\_

Drillers Remarks: \_\_\_\_\_  
\_\_\_\_\_  
\_\_\_\_\_

**CODED**

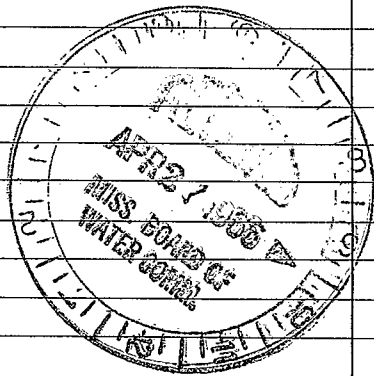

(Use Back Side)

Well No.

Retain this copy for your office files.

