

**LEFLORE**  
**C34**  
**6-30-73**

MISSISSIPPI  
 BOARD OF WATER COMMISSIONER **CODED**  
 416 North State Street  
 Jackson, Mississippi 39201

**WATER WELL DRILLERS LOG**

**6-30** 19 **73** **ZDYER WELL & IRRIGATION SERVICE** **LEFLORE**  
 date well completed firm name county well located

LANDOWNER: **GARY & LARRY CHITTON**

description of formations encountered

from to

**Pee Dee Dist Co.**

**CLAY**  
**SAND**  
**SAND GRAVEL**

**0 30**  
**30 40**  
**40 103**

**SCHLATER, MISS**  
 (mailing address)

**WELL LOCATION:**

sec **20** T **21** N R **2** E  
**6** miles **N.W.** of **SCHLATER**  
 (distance) (direction) (nearest town)

**WELL PURPOSE: IRRIGATION**  
 (home, irrigation, municipal, industrial)

**WELL COMPLETION DATA:**

- (1) diameter (inches) **16"**
- (2) total depth (feet) **103'**
- (3) static water level (feet) **19'** below top of ground.
- (4) casing **PVC**, **63'**  
 (material) (depth)  
**16"** if telescope see back.  
 (size)
- (5) screen **40'**, **63'**  
 (length) (depth to top)  
**16"**, **PVC INCO**  
 (size) (material)
- (6) pump **50** **2750**  
 (HP) (yield gpm)  
**ELEC**  
 (type power)
- (7) electric log **No**  
 (yes or no)
- (organization running log)
- (8) how well bottom plugged **PLATE**

**CODED**


DRILLERS REMARKS:

**OCT 25 1973**

MISS. BD. OF  
 WATER COMMISSIONERS

If well telescopes please sketch and show depths.

GROUND LEVEL

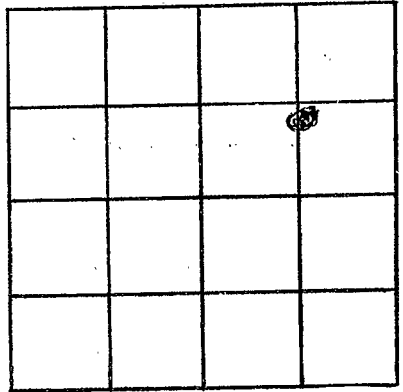

SECTION 20

Please indicate well location X.

ADDITIONAL INFORMATION

If more than one screen, show locations of each on sketch.