

Leflore

C40
2-3-64

WATER WELL DRILLERS LOG

CODED

Date: FEB. 3, 1964, Driller: DELTA DRILLING Co. County LEFLORE

(Name)

(1) Owner of Land: WATTS PLANTING Co.

(Name)

SCHWATER, MISS.

(Address)

(2) Location: SW 1/4, SW 1/4, Sec. 13 T22N R4W

2

_____ miles _____ of _____
(distance) (direction) (Nearest Town)

(3) Topography: _____

(Hilly) (Flat) (Level)

(4) Purpose of Well: DOMESTIC

(Domestic Irrigation
Municipal, Industrial, Other)

Information upon completion of well:

(1) Diameter 4 inches.

(2) Total Depth 1054 feet.

(3) Water Level FLOWS feet below top of ground.

(4) Cased to _____, Size _____

(5) Screen: Size 2", Length 40'
2" PERFORATED PIPE

(6) Were any formations sealed against pollution?


_____ yes, _____ no.

If YES depth of formation _____

Why _____

Drillers Remarks: 20' STRAINER SET IN SAND ~~ENCOUNTERED~~ ENCOUNTERED AT 928' - 40' OF 2" PIPE CASING BETWEEN THE 2 - 20' SECTIONS OF STRAINER.

Description & Color of Materials Sand, Clay, Red Clay, Shell, etc.	Thick- ness Feet	Depth Feet
GUMBO	29	29
SAND	35	64
GRAVEL	54	118
GUMBO	40	158
SHALE	32	190
SAND	81	271
SHALE	85	356
GUMBO CODED	64	420
SAND	20	440
GUMBO	129	569
SAND	121	690
SHALE	33	723
SAND	22	745
GUMBO	25	770
SHALE w/10" ROCK	37	807
GREEN SAND w/18" ROCK	50	857
SHALE	12	869
GREEN SAND w/10" ROCK	40	909
SHALE	13	922
GREEN SAND	80	1002
SHALE w/18" ROCK	38	1000
GREEN SAND	48	1048
GUMBO	6	1054

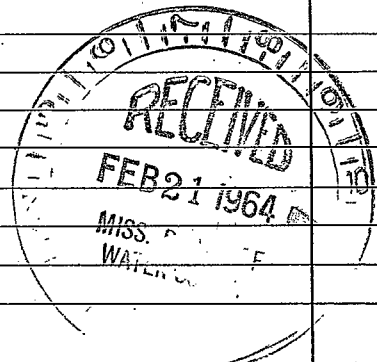

(Use Back Side)

Well No.

100
100