

LEFLORE  
 C 41  
 4-68

MISSISSIPPI  
 BOARD OF WATER COMMISSIONERS  
 416 North State Street  
 Jackson, Mississippi 39201

CODED

WATER WELL DRILLERS LOG

4-16 1968 Dyer Well Irr. LEFLORE  
 date well completed firm name county well located

LANDOWNER: HUNTER CHITTON

description of formations encountered	from	to
	TOP SOIL	0
CLAY	13	23
BLUE CLAY	23	33
COARSE SAND	33	43
COARSE SAND + Pea Gravel	43	63
MED. SAND + GRAVEL	63	73
COARSE SAND + LARGE GRAVEL	73	83
ROCK	84	

SCHLATER,

MISS.

(mailing address)

WELL LOCATION:

sec 27 T 21 N R 2 E  
 3 miles NW of SCHLATER  
 (distance) (direction) (nearest town)

WELL PURPOSE: IRRIGATION  
 (home, irrigation, municipal, industrial)

WELL COMPLETION DATA:

- (1) diameter (inches) 16"
- (2) total depth (feet) 82'
- (3) static water level (feet) 18' below top of ground.
- (4) casing Blue IR, 42' (material), (depth)  
 16" (size) if telescope see back.
- (5) screen 40', 42' (length), (depth to top)  
 16" (size), Blue IR (material)
- (6) pump 40 (HP), 2000 (yield gpm)  
 Elec. (type power)
- (7) electric log No. (yes or no)
- (organization running log)
- (8) how well bottom plugged RATS


CODED

DRILLERS REMARKS:

MAY 23 1968  
 MISS. Bd. of WATER COMMISSIONERS

If well telescopes please sketch and show depths.

GROUND LEVEL

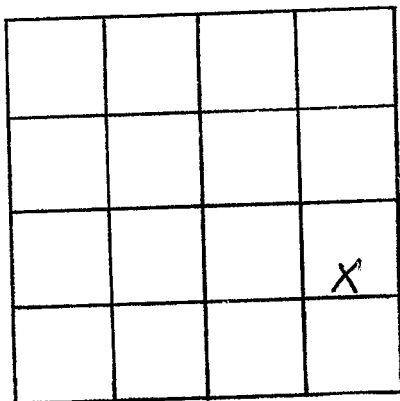

SECTION 27

Please indicate well location X.

ADDITIONAL INFORMATION

If more than one screen, show locations of each on sketch.