

MISSISSIPPI
BOARD OF WATER COMMISSIONERS
416 North State Street
Jackson, Mississippi 39201

CODED

WATER WELL DRILLERS LOG

Reflex
C42
6-68

6-4 1968 Dyer Well Dr. Leflore
date well completed firm name county well located

LANDOWNER:

PEE DEE PET. Co.

description of formations encountered

from to

SCILLATOR, Miss.
(mailing address)

| | | |
|------------------|-----|-----|
| CLAY | 0 | 28 |
| FINE BROWN SAND | 28 | 33 |
| FINE WHITE SAND | 33 | 45 |
| COARSE SAND | 45 | 64 |
| SAND & PEER ROCK | 64 | 87 |
| COARSE SAND | 87 | 102 |
| SAND & GRAVEL | 102 | 109 |

WELL LOCATION:

sec 26 T. 4 N R. 2 W

miles of (distance) (direction) (nearest town)

WELL PURPOSE: IRR.
(home, irrigation, municipal, industrial)

WELL COMPLETION DATA:

CODED


- (1) diameter (inches) 16"
- (2) total depth (feet) 109'
- (3) static water level (feet) 18' below top of ground.
- (4) casing D.I. 69', (material), (depth)
16" (size) if telescope see back.
- (5) screen 40' 69', (length), (depth to top)
16" (size), BEX. INGOT. (material)
- (6) pump 40 2000 (HP) (yield gpm)
ELEC. (type power)
- (7) electric log No (yes or no)
- (organization running log)
- (8) how well bottom plugged PLATE

DRILLERS REMARKS:

JUNE 17 1968
MISS. BOARD OF
WATER COMMISSIONERS

If well telescopes please sketch and show depths.

GROUND LEVEL

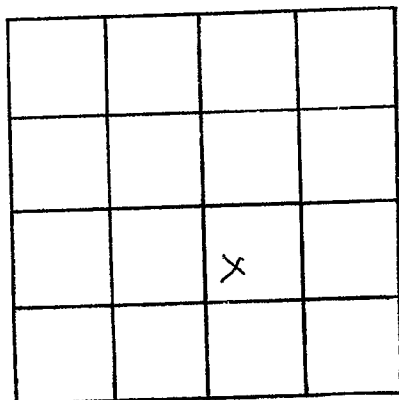

SECTION 26

Please indicate well location X.

ADDITIONAL INFORMATION

If more than one screen, show locations of each on sketch.