

Leflore
C 43
 8-16-68

MISSISSIPPI
 BOARD OF WATER COMMISSIONERS
 416 North State Street
 Jackson, Mississippi 39201

CODED

WATER WELL DRILLERS LOG

8-16-68 date well completed 19 Butane Gas Co. of Wood firm name Leflore county well located

LANDOWNER:
 W. P. Brown
 Schlater Miss.
 (mailing address)


description of formations encountered	from	to
Clay	0	10
SAND	10	40
SAND + GRAVEL	40	91

WELL LOCATION:
 sec. 3² T 21 N R 2 E
 2 miles ~~ENE~~ NE of Schlater
 (distance) (direction) (nearest town)

WELL PURPOSE: IRR.
 (home, irrigation, municipal, industrial)

- WELL COMPLETION DATA:
- (1) diameter (inches) 6"
 - (2) total depth (feet) 91
 - (3) static water level (feet) 19 below top of ground.
 - (4) casing Steel 51 (material), (depth)
 6" (size) if telescope see back.
 - (5) screen 40 (length), (depth to top)
 6" (size), Steel (material)
 - (6) pump 30 (HP), 1000 (yield gpm)
 TRACTOR (type power)
 - (7) electric log NO (yes or no)
 (organization running log)
 - (8) how well bottom plugged Steel Plate Welded

CODED

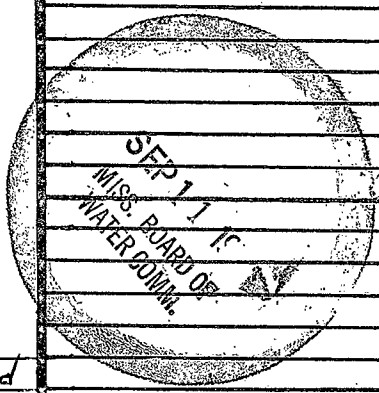

DRILLERS REMARKS: CR

If well telescopes please sketch and show depths.

GROUND LEVEL

	X		

SECTION 32

Please indicate well location X.

ADDITIONAL INFORMATION

If more than one screen,
show locations of each on sketch.