

LEFLORE

C 48

4-1-75

MISSISSIPPI
 BOARD OF WATER COMMISSIONERS
 416 North State Street
 Jackson, Mississippi 39201

WATER WELL DRILLERS LOG CODED

April 1, 1975 Dyer-Sullivan Inc. Leflore
 date well completed firm name county well located

LANDOWNER: M.C. Tillman #1

R.R. 1

Monter City, Miss. 38344
 (mailing address)

description of formations encountered	from to	
Clay	0	25
FINE SAND	25	67
SAND + GRAVEL	67	127

WELL LOCATION:


sec. 12 T. 21 (N) R. 2 E
 4 miles N of Schuler
 (distance) (direction) (nearest town)

WELL PURPOSE: Irrigation
 (home, irrigation, municipal, industrial)

WELL COMPLETION DATA:

- (1) diameter (inches) 16"
- (2) total depth (feet) 107'
- (3) static water level (feet) 13 below above top of ground.
- (4) casing Blk Iron, 67' (material) (depth)
 16" (size) if telescope see back.
- (5) screen 40', 67' (length) (depth to top)
 16", Blk Ingot (size) (material)
- (6) pump 60 (HP) 3000 (yield gpm)
 Diesel (type power)
- (7) electric log No (yes or no)
 (organization running log)
- (8) how well bottom plugged Plate

CODED

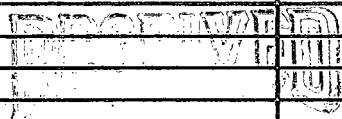

OCT 18 1975

DRILLERS REMARKS:

If well telescopes please sketch and show depths.

GROUND LEVEL

	X		

SECTION 12

Please indicate well location X.

ADDITIONAL INFORMATION

If more than one screen,
show locations of each on sketch.