

LEFLORE  
C 49  
4-3-75

MISSISSIPPI  
BOARD OF WATER COMMISSIONERS  
416 North State Street  
Jackson, Mississippi 39201

WATER WELL DRILLERS LOG **CODED**

April 3, 1975 Dyer-Sullivan, Inc. Leflore  
date well completed firm name county well located

LANDOWNER: M.C. Tillman #2  
R.R. 1  
Minter City, Miss. 38944  
(mailing address)

description of formations encountered	from to	
Clay	0	32
Fine Sand	32	57
SAND & GRAVEL	57	58


WELL LOCATION:  
sec. 1 T. 21 N. R. 2 E. S. 5 W.  
4 1/2 miles N of Schlater  
(distance) (direction) (nearest town)

WELL PURPOSE: ~~irrigation~~  
(home, irrigation, municipal, industrial)

**CODED**

WELL COMPLETION DATA:

- (1) diameter (inches) 16"
- (2) total depth (feet) 98'
- (3) static water level (feet) 10 below above top of ground.
- (4) casing Blk Iron, 57'  
(material) (depth)  
16" If telescope see back.  
(size)
- (5) screen 40', 57'  
(length) (depth to top)  
12", Blk Ingot  
(size) (material)
- (6) pump 600, 3000  
(HP) (yield gpm)  
Diesel  
(type power)
- (7) electric log No  
(yes or no)
- (organization running log)
- (8) how well bottom plugged Plate

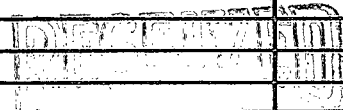

OCT 1 2 1975

DRILLERS REMARKS:

