

LEFLORE
C 50
12-22-76

MISSISSIPPI
BOARD OF WATER COMMISSIONERS
416 North State Street
Jackson, Mississippi 39201

WATER WELL DRILLERS LOG

CODED

①

12-22-1976 date well completed Dyet-Sullivan firm name LeFlore county well located

LANDOWNER: Hobson GATY

SCHALTER, MISS.

(mailing address)

description of formations encountered

from to

CLAY	0	14'
Pine Sand	14'	26'
Coarse Sand	26'	44'
Coarse Sand	44'	165'

WELL LOCATION:

sec. 32 T. 24 N R. 2 E
S W
4 miles W of SCHALTER
(distance) (direction) (nearest town)

WELL PURPOSE: IRR
(home, irrigation, municipal, industrial)

WELL COMPLETION DATA:

- (1) diameter (inches) 12"
- (2) total depth (feet) 108'
- (3) static water level (feet) 16' below top of ground.
- (4) casing Steel, 65', (material) (depth)
12" (size) If telescope see back.
- (5) screen 40', 68" (length) (depth to top)
12" (size), Steel (material)
- (6) pump 25 (HP), 1400 (yield gpm)
Electric (type power)
- (7) electric log NO (yes or no)
- (8) how well bottom plugged PLATE


RECEIVED
JAN 11 1977

DRILLERS REMARKS:

Mississippi...

If well telescopes please sketch and show depths.

GROUND LEVEL

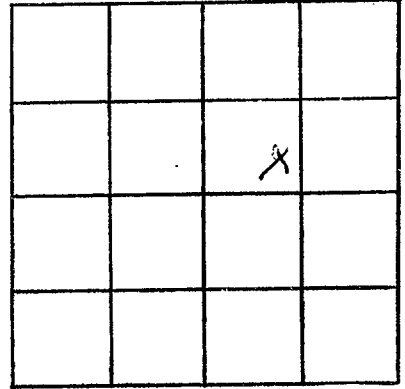

SECTION _____

Please indicate well location X.

ADDITIONAL INFORMATION

If more than one screen,
show locations of each on sketch.