

MISSISSIPPI  
BOARD OF WATER COMMISSIONERS  
416 North State Street  
Jackson, Mississippi 39201

CODED ①

WATER WELL DRILLERS LOG

DYER-SULLIVAN, INC.

LEFLORE  
C 54  
2.8-77

2-8 1977 date well completed      firm name      LeFlore county well located

LANDOWNER: <u>W. W. Catlett</u>	description of formations encountered	from	to
<u>R. R.</u>			
<u>Ruleville, Miss</u> (mailing address)	<u>CLAY</u>	<u>0</u>	<u>16</u>
	<u>Fine Sand</u>	<u>16</u>	<u>29</u>
	<u>Coarse Sand &amp; Gravel</u>	<u>29</u>	<u>114</u>

WELL LOCATION:  
sec. 33 T 21 N R 2 E  
9 miles West of Ruleville  
(distance) (direction) (nearest town)

WELL PURPOSE: LF  
(home, irrigation, municipal, industrial)

WELL COMPLETION DATA:

(1) diameter (inches) 12"

(2) total depth (feet) 114'

(3) static water level (feet) 19 below above top of ground.

(4) casing Steel 74'  
(material) (depth)  
12" if telescope see back.  
(size)

(5) screen 40' 74'  
(length) (depth to top)  
12" Steel  
(size) (material)

(6) pump 40 1800  
(HP) (yield gpm)  
Disiel  
(type power)

(7) electric log No  
(yes or no)

(organization running log)

(8) how well bottom plugged PLATE

CODED


REGISTERED  
MAR 20 1977

DRILLERS REMARKS:

MISS. BD. OF WATER COMMISSIONERS

If well telescopes please sketch and show depths.

GROUND LEVEL

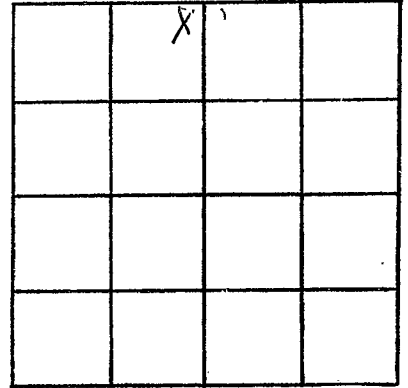

SECTION \_\_\_\_\_

Please indicate well location X.

ADDITIONAL INFORMATION

If more than one screen,  
show locations of each on sketch.