

LEFLORE

C 55

2-10-77

MISSISSIPPI  
 BOARD OF WATER COMMISSIONERS  
 416 North State Street  
 Jackson, Mississippi 39201

①

WATER WELL DRILLERS LOG

DYER-SULLIVAN, INC.

LeFlore

2-10  
date well completed

1977  
firm name

county well located

LANDOWNER: N. W. Cabert

R.R.

description of formations encountered

from

to

Ruleville, MISS  
(mailing address)

CLAY

0

19

Fine Sand

19

32

Coarse Sand & Gravel

32

115

SAUD ROCK

118

WELL LOCATION:

sec. 30 T. 21 N R. 2 E  
W

8 miles East of Ruleville  
(distance) (direction) (nearest town)

WELL PURPOSE: I.F.F.  
(home, irrigation, municipal, industrial)

WELL COMPLETION DATA:

- (1) diameter (inches) 16"
- (2) total depth (feet) 118'
- (3) static water level (feet) 12' below top of ground.

(4) casing Steel, 28'  
(material) (depth)

16" if telescope see back.  
(size)

(5) screen 40', 28'  
(length) (depth to top)

16", Steel  
(size) (material)

(6) pump 460, 2200  
(HP) (yield gpm)

Diesel  
(type power)

(7) electric log NO  
(yes or no)

(organization running log)

(8) how well bottom plugged Plate


DRILLERS REMARKS:

REGISTERED  
MAR 18 1977

MISS. BD. OF WATER COMMISSIONERS

If well telescopes please sketch and show depths.

GROUND LEVEL

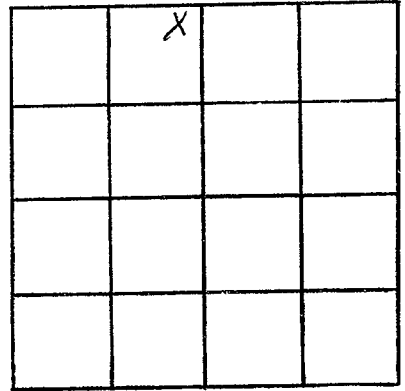

SECTION \_\_\_\_\_

Please indicate well location X.

ADDITIONAL INFORMATION

If more than one screen,  
show locations of each on sketch.