

LEFLORE  
 C56  
 2-5-77

MISSISSIPPI  
 BOARD OF WATER COMMISSIONERS  
 416 North State Street  
 Jackson, Mississippi 39201

CODED

WATER WELL DRILLERS LOG

DYER-SULLIVAN, INC.

2-5 1977 date well completed  
 firm name  
 LeFlore county well located

LANDOWNER: Bill Palmtree  
 Miter City, Miss

description of formations encountered

from to

CLAY	0	9
CLAY & SAND	9	19
FINE SAND	19	24
CORSE SAND & GRAVEL	24	111
ROCK	111	

(mailing address)

WELL LOCATION:

sec. 8 T. 21 N R. 2 E  
 S W  
 7 miles N of Sunnyside  
 (distance) (direction) (nearest town)

WELL PURPOSE: 1st.  
 (home, irrigation, municipal, industrial)

WELL COMPLETION DATA:

- (1) diameter (inches) 12"
- (2) total depth (feet) 111'
- (3) static water level (feet) 18' below top of ground.
- (4) casing Steel, 71' (material), (depth),  
 12" (size) if telescope see back.
- (5) screen 40' (length), 71' (depth to top),  
 12" (size), Steel (material)
- (6) pump 40 (HP), 1800 (yield gpm),  
 Diesel (type power)
- (7) electric log No (yes or no)

(organization running log)

(8) how well bottom plugged PLATE

DRILLERS REMARKS:


CODED

RECEIVED  
 MAR 18 1977

MISS. Bd. OF WATER COMMISSIONERS

If well telescopes please sketch and show depths.

GROUND LEVEL

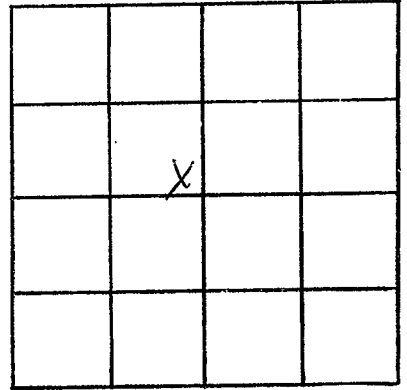

SECTION \_\_\_\_\_

Please indicate well location X.

ADDITIONAL INFORMATION

If more than one screen,  
show locations of each on sketch.