

Leflore
 C 57
 11-2-77

MISSISSIPPI
 BOARD OF WATER COMMISSIONERS CODED
 416 North State Street
 Jackson, Mississippi 39201

WATER WELL DRILLERS LOG

BUTANE GAS COMPANY

11-2-77 19
 date well completed

OF GREENWOOD

Leflore
 county well located

| LANDOWNER: | description of formations encountered | from | to |
|---|---------------------------------------|------|-----|
| Buckhorn Planting Co. | CLAY | 0 | 40 |
| Schlater | SAND | 40 | 60 |
| (mailing address) | SAND + GRAVEL | 60 | 100 |
| WELL LOCATION: | | | |
| sec. 27 T. 21 N R. 2 E S ₂ W 3 1/2 miles NW of Schlater (distance) (direction) (nearest town) | | | |
| WELL PURPOSE: IRRIGATION (home, irrigation, municipal, industrial) | | | |
| WELL COMPLETION DATA: | | | |
| (1) diameter (inches) 16" | | | |
| (2) total depth (feet) 100 | | | |
| (3) static water level (feet) 25 below top of ground. | | | |
| (4) casing Steel, 60 (material) (depth) 16" (size) if telescope see back. | | | |
| (5) screen 40, 60 (length) (depth to top) | | | |
| (6) pump 60, 3000 (HP) (yield gpm) Elec (type power) | | | |
| (7) electric log NO (yes or no) | | | |
| (organization running log) | | | |
| (8) how well bottom plugged Steel Plate | | | |
| DRILLERS REMARKS: | | | |


CODED

RECEIVED
 NOV - 7 1977

MISS. BD. OF WATER COMM.

If well telescopes please sketch and show depths.

GROUND LEVEL

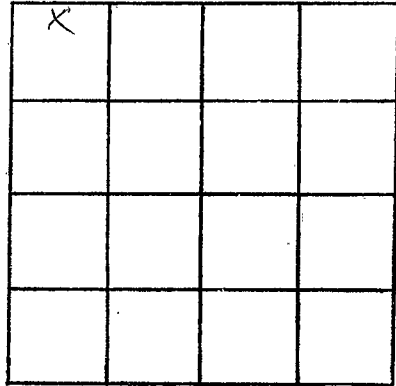

SECTION 27

Please indicate well location X.

ADDITIONAL INFORMATION

Lined area for additional information.

If more than one screen, show locations of each on sketch.