

LeFlore
 259
 11-2-77

MISSISSIPPI
 BOARD OF WATER COMMISSIONERS
 416 North State Street
 Jackson, Mississippi 39201

WATER WELL DRILLERS LOG
 BUTANE GAS COMPANY

CODED
 REGISTERED

11-2-77 19
 date well completed

OF GREENWOOD

county well located

LANDOWNER:
 Buckhorn Planting Co.
 Schlater
 (mailing address)

description of formations encountered	from	to
Clay	0	40
Sand	40	60
Sand + Gravel	60	100

WELL LOCATION:
 sec. 27 T. 24 N. R. 2 E.
 S. W.
 2 1/2 miles NW of Schlater
 (distance) (direction) (nearest town)

WELL PURPOSE: IRRIGATION
 (home, irrigation, municipal, industrial)

CODED

WELL COMPLETION DATA:

(1) diameter (inches) 16"

(2) total depth (feet) 100

(3) static water level (feet) 25 below top of ground.

(4) casing Steel, 60' (material), (depth)
 16" (size) If telescope see back.

(5) screen 40' 60' (length), (depth to top)
 16" (size), Steel (material)

(6) pump 60 3000 (HP), (yield gpm)

Flec- (type power)

(7) electric log No (yes or no)

(organization running log)

(8) how well bottom plugged
 Steel Plate

DRILLERS REMARKS:


RECEIVED

NOV - 7 1977

MISS. BD. OF WATER COMM

If well telescopes please sketch and show depths.

GROUND LEVEL

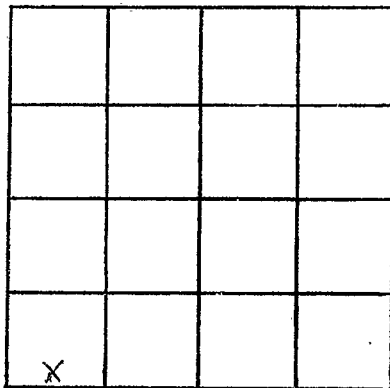

SECTION 27

Please indicate well location X.

ADDITIONAL INFORMATION

If more than one screen, show locations of each on sketch.