

LEFLORE  
 C60  
 10-12-77

MISSISSIPPI  
 BOARD OF WATER COMMISSIONERS  
 416 North State Street  
 Jackson, Mississippi 39201

CODED

WATER WELL DRILLERS LOG

10-12-77 date well completed      Dyer Well & Irr. firm name      Leflore county well located

LANDOWNER: Hopson Gary  
 P.O. Box 196  
 Schlater, Miss.  
 (mailing address)

description of formations encountered	from	to
Clay	0	13
Clay	14	23
FINE SAND	24	33
FINE SAND	34	43
COURSE SAND	44	53
SAND + GRAVEL	54	63
SAND + GRAVEL	64	73
SAND + GRAVEL	74	83
SAND + GRAVEL	84	93
SAND + GRAVEL	94	94

WELL LOCATION:  
 sec. 32 T. 21 (N) R. 2 E  
 S W  
 5 miles WEST of Schlater  
 (distance) (direction) (nearest town)

WELL PURPOSE: Irrigation  
 (home, irrigation, municipal, industrial)

- WELL COMPLETION DATA:
- (1) diameter (inches) 16"
  - (2) total depth (feet) 96'
  - (3) static water level (feet) 17' below top of ground
  - (4) casing Steel 56' (material) (depth)  
 16" (size) if telescope see back.
  - (5) screen 40' 56' (length) (depth to top)  
 16" (size) STEEL (material)
  - (6) pump 60 2800 (HP) (yield gpm)  
 Electric (type power)
  - (7) electric log NO (yes or no)
  - (8) how well bottom plugged Plate

CODED

RECEIVED  
 NOV 17 1977

MISS. BD. OF WATER COMM

DRILLERS REMARKS:

If well telescopes please sketch and show depths.

GROUND LEVEL

Casing

56' →


Screen

40' →

20' →

20' →

Plate →

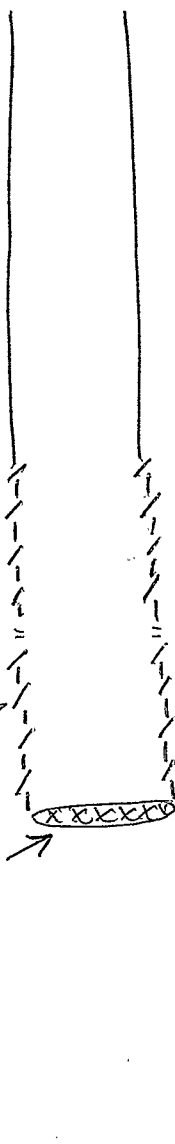

			X

SECTION 32

Please indicate well location X.

ADDITIONAL INFORMATION

At 97' Driller started  
to cut rock.

If more than one screen,  
show locations of each on sketch.