

LeFlore
 C 61
 4/3/78

MISSISSIPPI
 BOARD OF WATER COMMISSIONERS
 416 North State Street
 Jackson, Mississippi 39201

WATER WELL DRILLERS LOG
 BUTANE GAS COMPANY

CODED

LeFlore

4-3-78
 date well completed

OF GREENWOOD

county well located

LANDOWNER:	description of formations encountered	from	to
Harold Coleman	Clay	0	20
Schlater	FINE SAND CODED	20	40
(mailing address)	SAND & PEAS GRAVEL	40	60
WELL LOCATION:	SAND & GRAVEL	60	100
sec. 27 T. 21 N. R. 2 E			
2 1/2 miles NW of Schlater			
(distance) (direction) (nearest town)			
WELL PURPOSE: FUR			
(home, irrigation, municipal, industrial)			
WELL COMPLETION DATA:			
(1) diameter (inches) 16"			
(2) total depth (feet) 100			
(3) static water level (feet) 17 below top of ground.			
(4) casing Steel, 60 (material) (depth)			
16" if telescope see back. (size)			
(5) screen 40, 60 (length) (depth to top)			
16" Steel (size) (material)			
(6) pump 60 3000 (HP) (yield gpm)			
Diesel (type power)			
(7) electric log NO (yes or no)			
(organization running log)			
(8) how well bottom plugged, Steel P.A.P.			
DRILLERS REMARKS:			


RECEIVED

APR - 6 1978

MISS. BD. OF WATER COMMISSIONERS

If well telescopes please sketch and show depths.

GROUND LEVEL

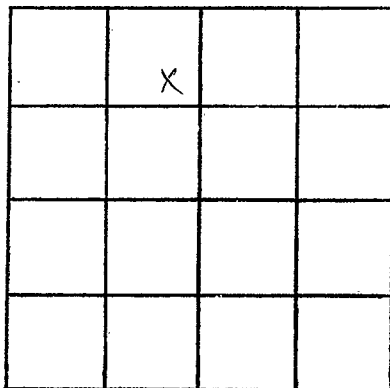

SECTION 27

Please indicate well location X.

ADDITIONAL INFORMATION

If more than one screen, show locations of each on sketch.