

LeFlore
 C63
 6/19/78

MISSISSIPPI
 BOARD OF WATER COMMISSIONERS
 416 North State Street
 Jackson, Mississippi 39201

CODED

WATER WELL DRILLERS LOG
 BUTANE GAS COMPANY

OF GREENWOOD

LeFlore
 county well located

6-19-78 19
 date well completed

LANDOWNER:
 Dewitt Corporation
 Greenwood
 (mailing address)

description of formations encountered	from	to
Sandy Clay	0	19
FINE SAND	19	30
COARSE SAND	30	40
SAND & PEA GRAVEL	40	50
SAND & GRAVEL	50	100

WELL LOCATION:
 sec. 7 T. 21 N. R. 2 E
 5 miles N of Schlater
 (distance) (direction) (nearest town)

WELL PURPOSE: IRR
 (home, irrigation, municipal, industrial)

- WELL COMPLETION DATA:
- (1) diameter (inches) 16
 - (2) total depth (feet) 100
 - (3) static water level (feet) 20 below top of ground.
 - (4) casing Steel 60 (material), (depth)
 - 16" (size) if telescope see back.
 - (5) screen 40 60 (length), (depth to top)
 - 16" Steel (size), (material)
 - (6) pump 60 3000 (HP), (yield gpm)
 - F/c. (type power)
 - (7) electric log No (yes or no)
 - (organization running log)
 - (8) how well bottom plugged Steel P.C.A.


CODED

RECEIVED
 JUN 23 1978
 MISSISSIPPI BOARD OF WATER COMMISSIONERS

DRILLERS REMARKS:

If well telescopes please sketch and show depths.

GROUND LEVEL

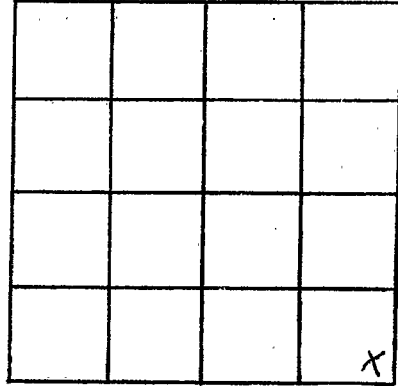

SECTION 7

Please indicate well location X.

ADDITIONAL INFORMATION

If more than one screen,
show locations of each on sketch.