

LEFLORE
C-69
4-16-80

MISSISSIPPI
BOARD OF WATER COMMISSIONERS
416 North State Street
Jackson, Mississippi 39201

CODED

WATER WELL DRILLERS LOG
BUTANE GAS COMPANY

4-16-80
date well completed

OF GREENWOOD

Leflore
county well located


LANDOWNER:	description of formations encountered	from	to
Dewitt Corporation Greenwood (mailing address)			
WELL LOCATION: sec. <u>4</u> T <u>24</u> N R <u>2</u> E W <u>7</u> miles <u>NW</u> of <u>Schlater</u> (distance) (direction) (nearest town)			
WELL PURPOSE: <u>IRR</u> (home, irrigation, municipal, industrial)			
WELL COMPLETION DATA:			
(1) diameter (inches) <u>16"</u>			
(2) total depth (feet) <u>98</u>			
(3) static water level (feet) <u>18</u> below top of ground.			
(4) casing <u>Steel</u> , <u>58'</u> (material) (depth) <u>16"</u> if telescope see back. (size)			
(5) screen <u>40'</u> , <u>58'</u> (length) (depth to top) <u>16"</u> , <u>Steel</u> (size) (material)			
(6) pump <u>60</u> <u>2500</u> (HP) (yield gpm) <u>Diesel</u> (type power)			
(7) electric log <u>no</u> (yes or no) (organization running log)			
(8) how well bottom plugged <u>Steel plate</u>			
DRILLERS REMARKS:			

CODED

DEPT. OF NATURAL RESOURCES
BUREAU OF LAND & WATER RESOURCES
RECEIVED
APR 22 1980

If well telescopes please sketch and show depths.

GROUND LEVEL

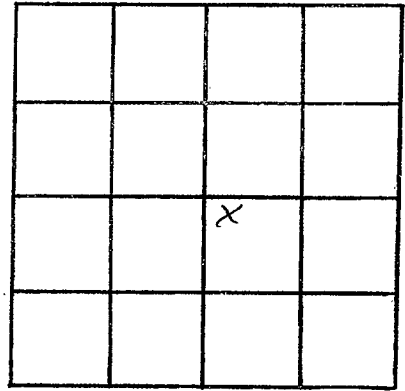

SECTION 4

Please indicate well location X.

ADDITIONAL INFORMATION

If more than one screen, show locations of each on sketch.