

Leflore
C-70
5/6/80

MISSISSIPPI
BOARD OF WATER COMMISSIONERS
416 North State Street
Jackson, Mississippi 39201

CODED

WATER WELL DRILLERS LOG
BUTANE GAS COMPANY

5-6-80 19 OF GREENWOOD Leflore
date well completed firm name county well located

LANDOWNER:
Harold Coleman
Schlater
(mailing address)

description of formations encountered	from	to
CLAY	0	30
SAND	30	50
SAND & GRAVEL	50	103

WELL LOCATION:
sec 30 T 21 N R 2 E
6 miles NW of Schlater
(distance) (direction) (nearest town)

CODED

WELL PURPOSE: IRR
(home, irrigation, municipal, industrial)

- WELL COMPLETION DATA:
- (1) diameter (inches) 16"
 - (2) total depth (feet) 103
 - (3) static water level (feet) 25 below above top of ground.
 - (4) casing Steel, 63,
(material) (depth)
16" If telescope see back.
(size)
 - (5) screen 40, 63
(length) (depth to top)
16", Steel
(size) (material)
 - (6) pump 50 2000
(HP) (yield gpm)
Elec
(type power)
 - (7) electric log No
(yes or no)

(organization running log)
 - (8) how well bottom plugged Steel Plate

DEPT. OF NATURAL RESOURCES
BUREAU OF LAND & WATER RESOURCES


MAY 19 1980

RECEIVED

DRILLERS REMARKS:

If well telescopes please sketch and show depths.

GROUND LEVEL

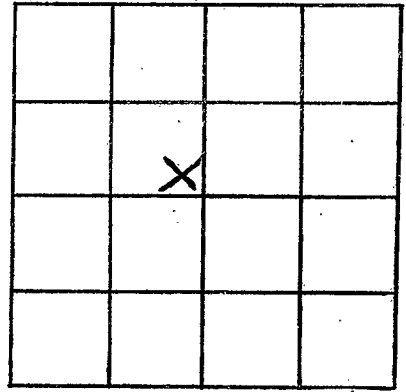

SECTION 30

Please indicate well location X.

ADDITIONAL INFORMATION

If more than one screen,
show locations of each on sketch.